
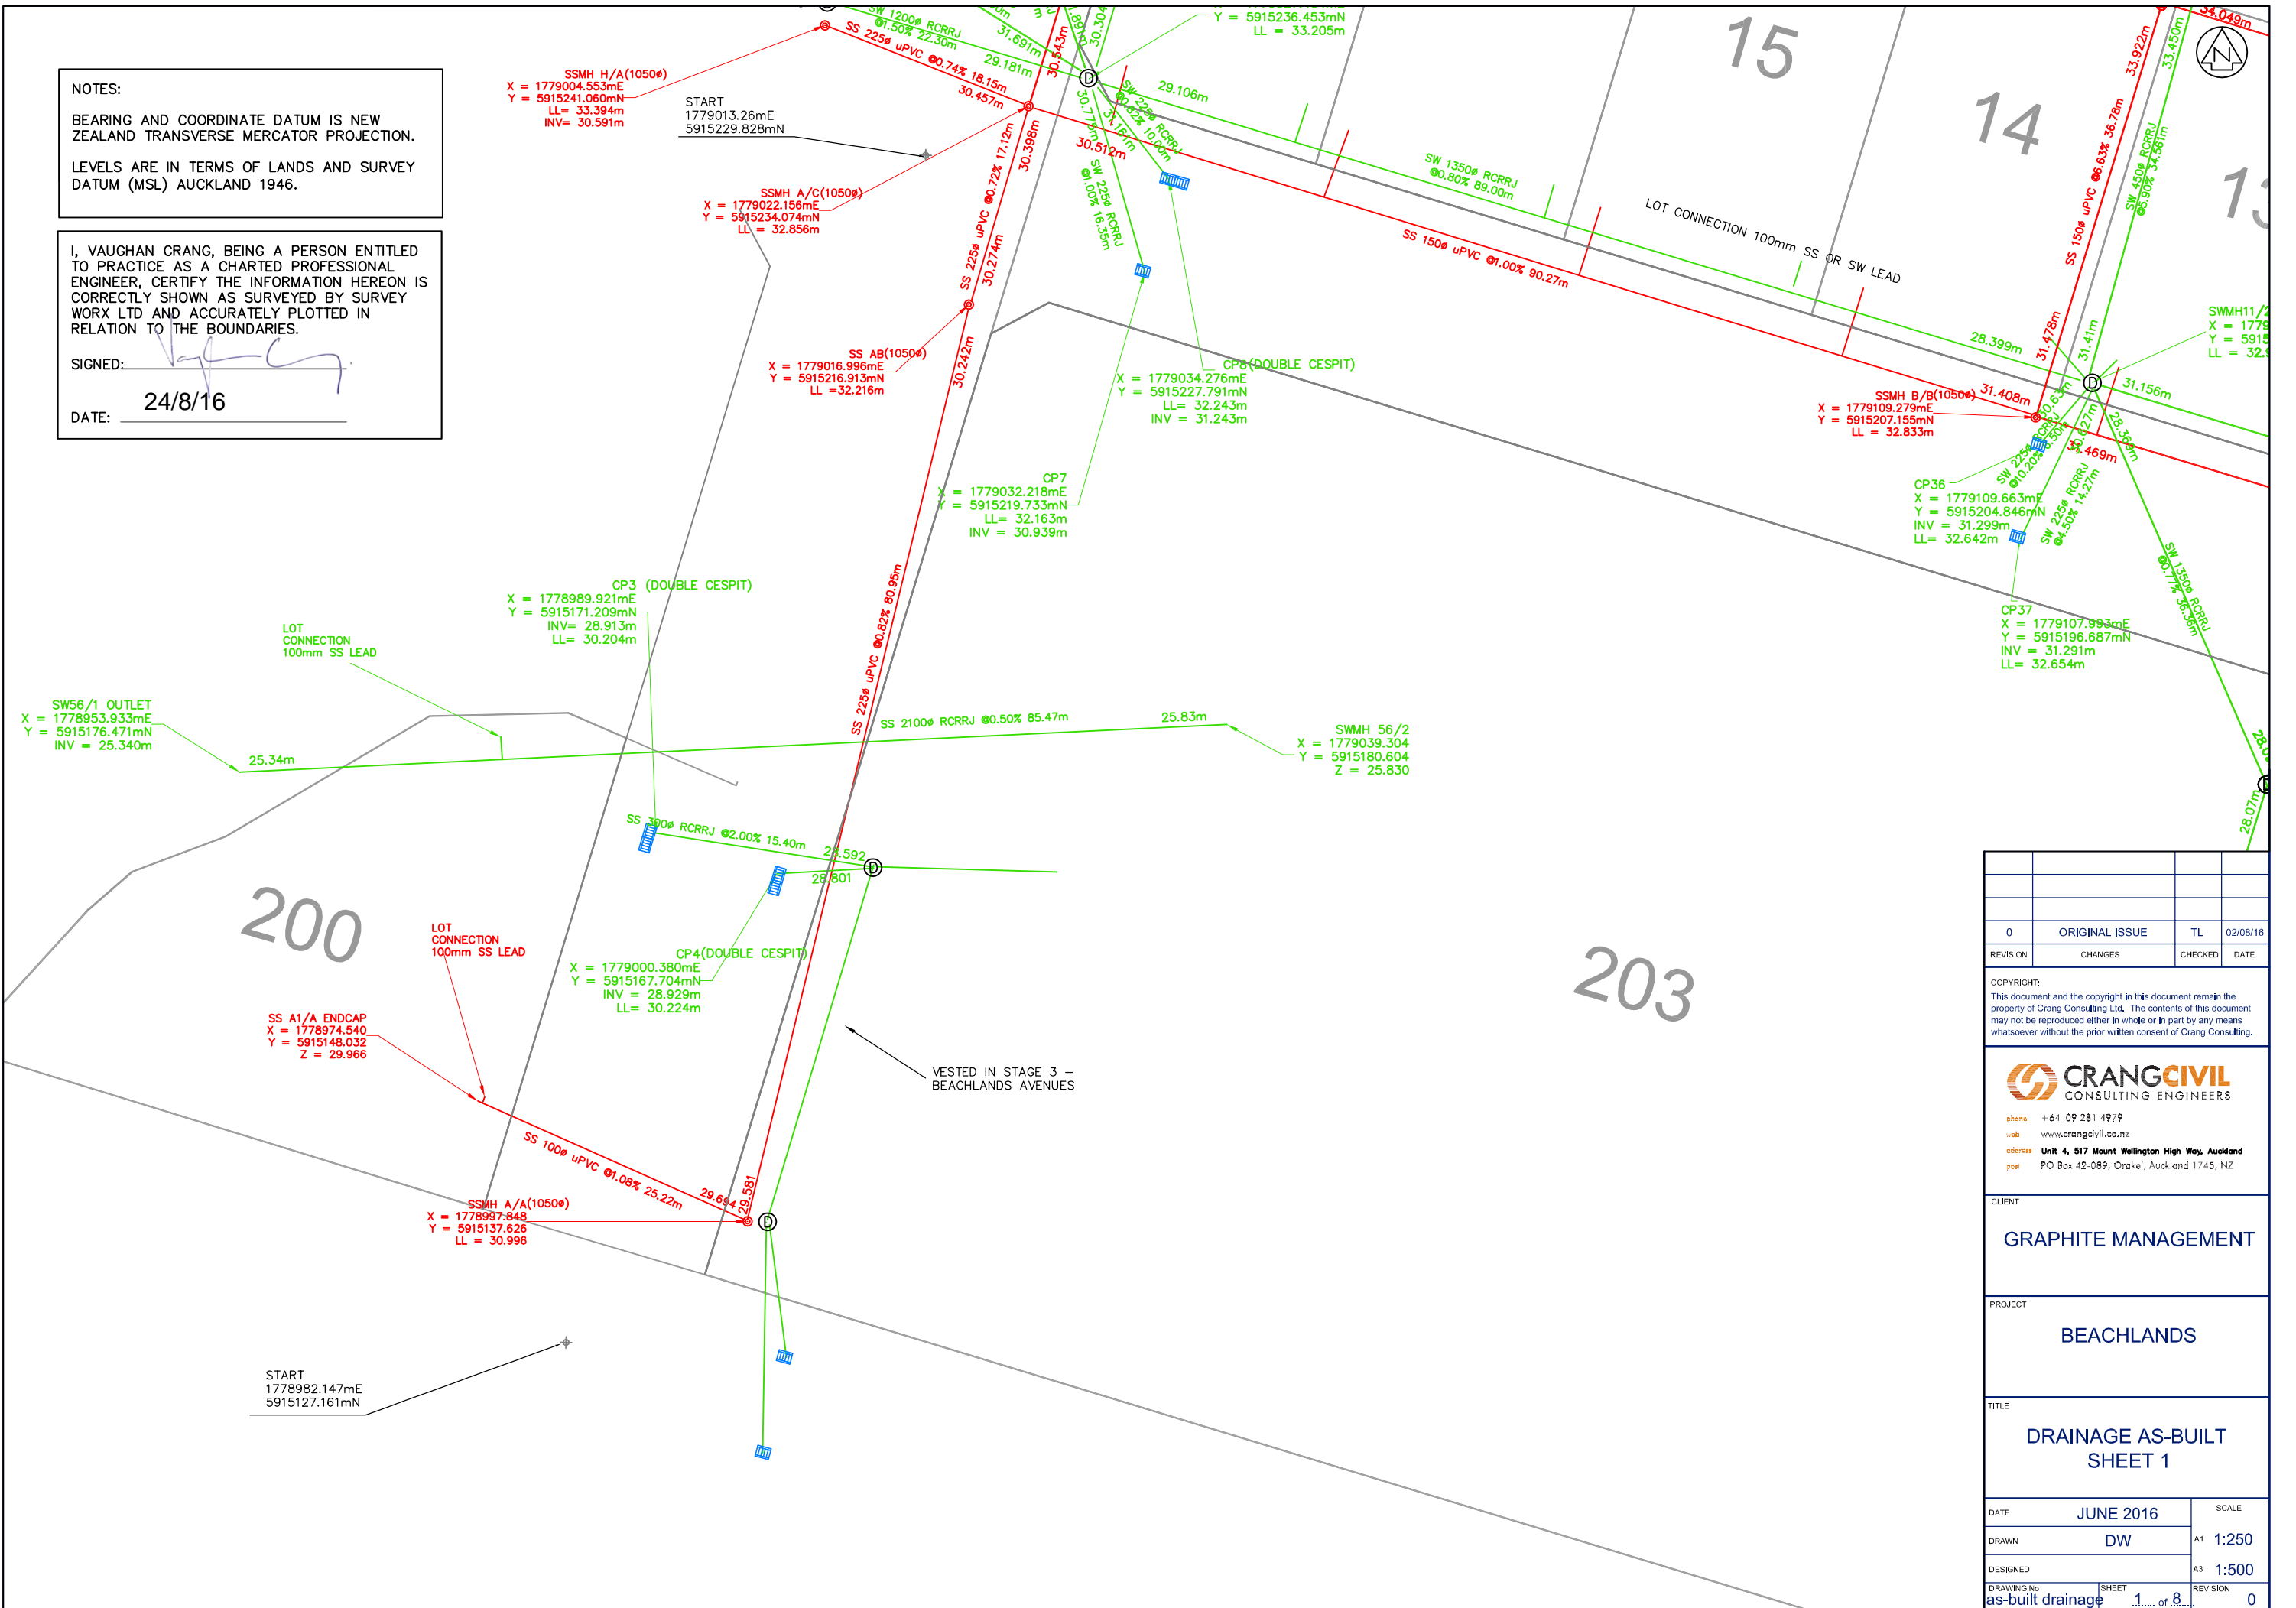



NOTES:  
 BEARING AND COORDINATE DATUM IS NEW ZEALAND TRANSVERSE MERCATOR PROJECTION.  
 LEVELS ARE IN TERMS OF LANDS AND SURVEY DATUM (MSL) AUCKLAND 1946.

I, VAUGHAN CRANG, BEING A PERSON ENTITLED TO PRACTICE AS A CHARTED PROFESSIONAL ENGINEER, CERTIFY THE INFORMATION HEREON IS CORRECTLY SHOWN AS SURVEYED BY SURVEY WORX LTD AND ACCURATELY PLOTTED IN RELATION TO THE BOUNDARIES.

SIGNED:   
 DATE: 24/8/16



0	ORIGINAL ISSUE	TL	02/08/16
REVISION	CHANGES	CHECKED	DATE
COPYRIGHT: This document and the copyright in this document remain the property of Crang Consulting Ltd. The contents of this document may not be reproduced either in whole or in part by any means whatsoever without the prior written consent of Crang Consulting.			
 phone +64 09 281 4979 web www.crangcivil.co.nz address Unit 4, 517 Mount Wellington High Way, Auckland post PO Box 42-089, Orakei, Auckland 1745, NZ			
CLIENT <b>GRAPHITE MANAGEMENT</b>			
PROJECT <b>BEACHLANDS</b>			
TITLE <b>DRAINAGE AS-BUILT SHEET 1</b>			
DATE	JUNE 2016	SCALE	
DRAWN	DW	A1	1:250
DESIGNED		A3	1:500
DRAWING No	SHEET	REVISION	
as-built drainage	1 of 8		0

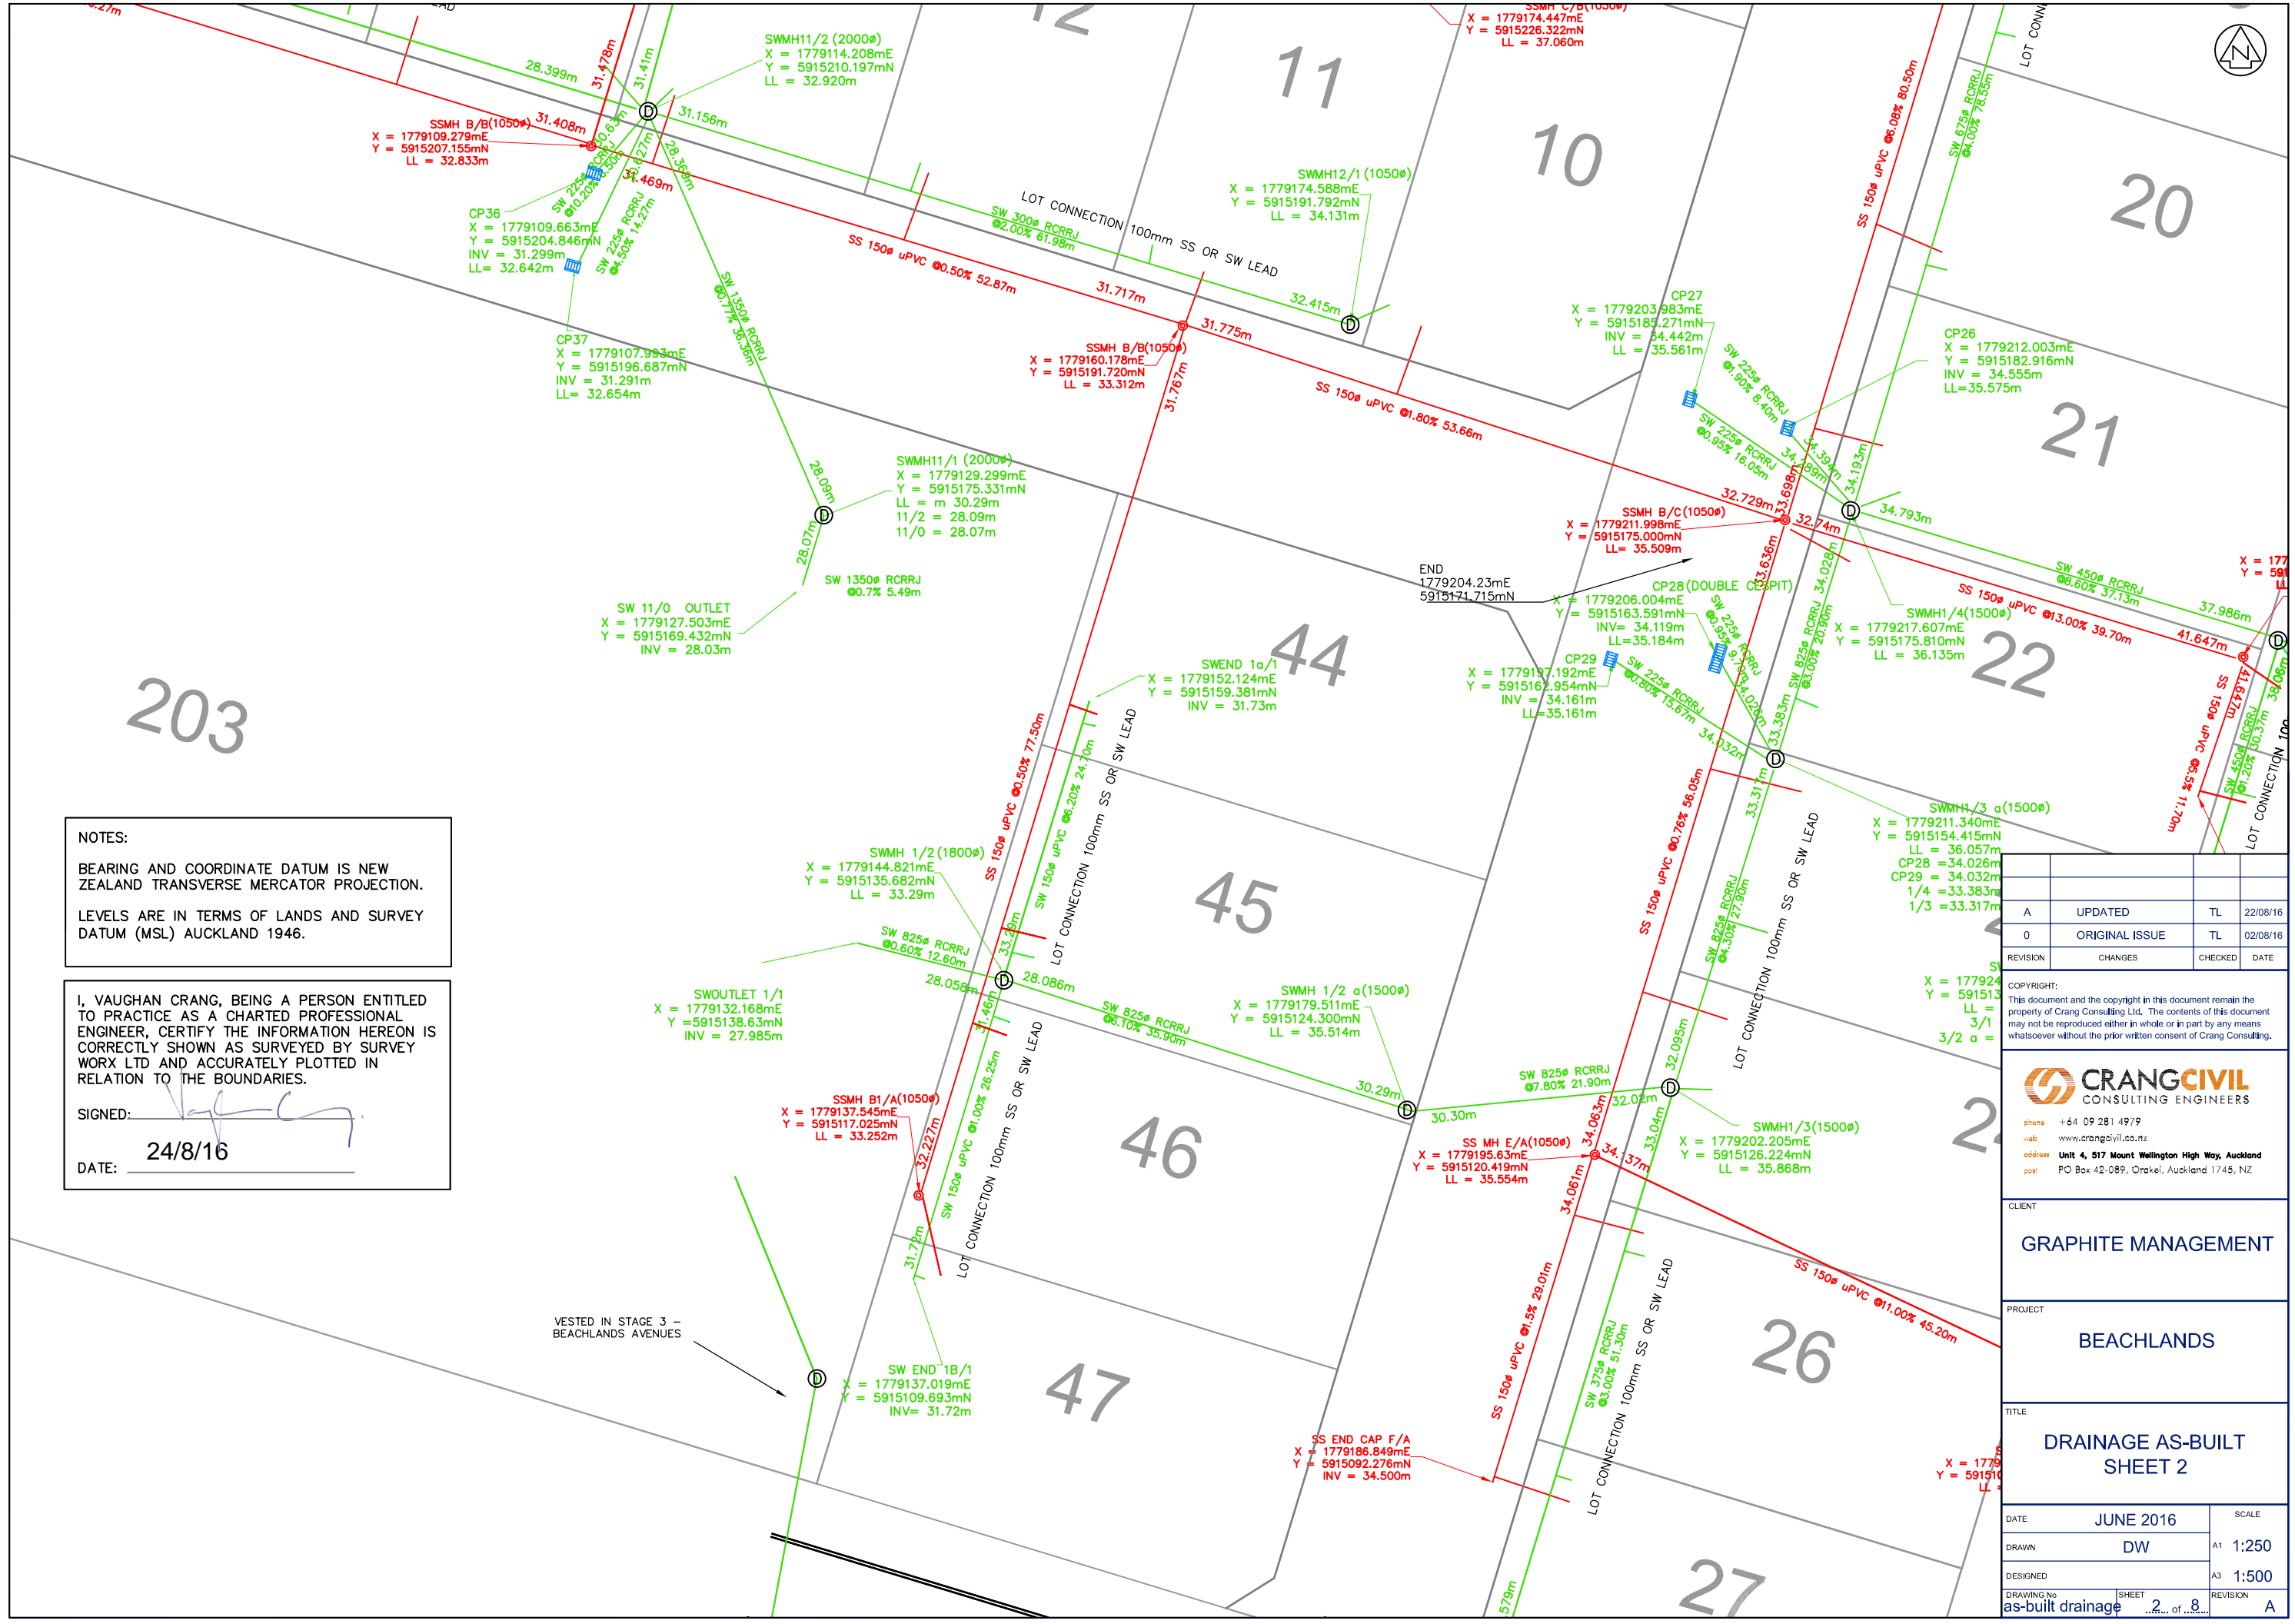

NOTES:  
 BEARING AND COORDINATE DATUM IS NEW ZEALAND TRANSVERSE MERCATOR PROJECTION.  
 LEVELS ARE IN TERMS OF LANDS AND SURVEY DATUM (MSL) AUCKLAND 1946.

I, VAUGHAN CRANG, BEING A PERSON ENTITLED TO PRACTICE AS A CHARTED PROFESSIONAL ENGINEER, CERTIFY THE INFORMATION HEREON IS CORRECTLY SHOWN AS SURVEYED BY SURVEY WORX LTD AND ACCURATELY PLOTTED IN RELATION TO THE BOUNDARIES.

SIGNED: *[Signature]*  
 DATE: 24/8/16

REVISION	CHANGES	CHECKED	DATE
A	UPDATED	TL	22/08/16
0	ORIGINAL ISSUE	TL	02/08/16

COPYRIGHT:  
 This document and the copyright in this document remain the property of Crang Consulting Ltd. The contents of this document may not be reproduced either in whole or in part by any means whatsoever without the prior written consent of Crang Consulting.

**CRANG CIVIL**  
 CONSULTING ENGINEERS

phone +64 09 281 4979  
 web www.crangcivil.co.nz  
 address Unit 4, 517 Mount Wellington High Way, Auckland  
 post PO Box 42-089, Orakei, Auckland 1745, NZ


CLIENT  
**GRAPHITE MANAGEMENT**

PROJECT  
**BEACHLANDS**

TITLE  
**DRAINAGE AS-BUILT SHEET 2**

DATE	SCALE
JUNE 2016	A1 1:250
DRAWN DW	A3 1:500
DESIGNED	REVISION
DRAWING No. as-built drainage	SHEET 2 of 8



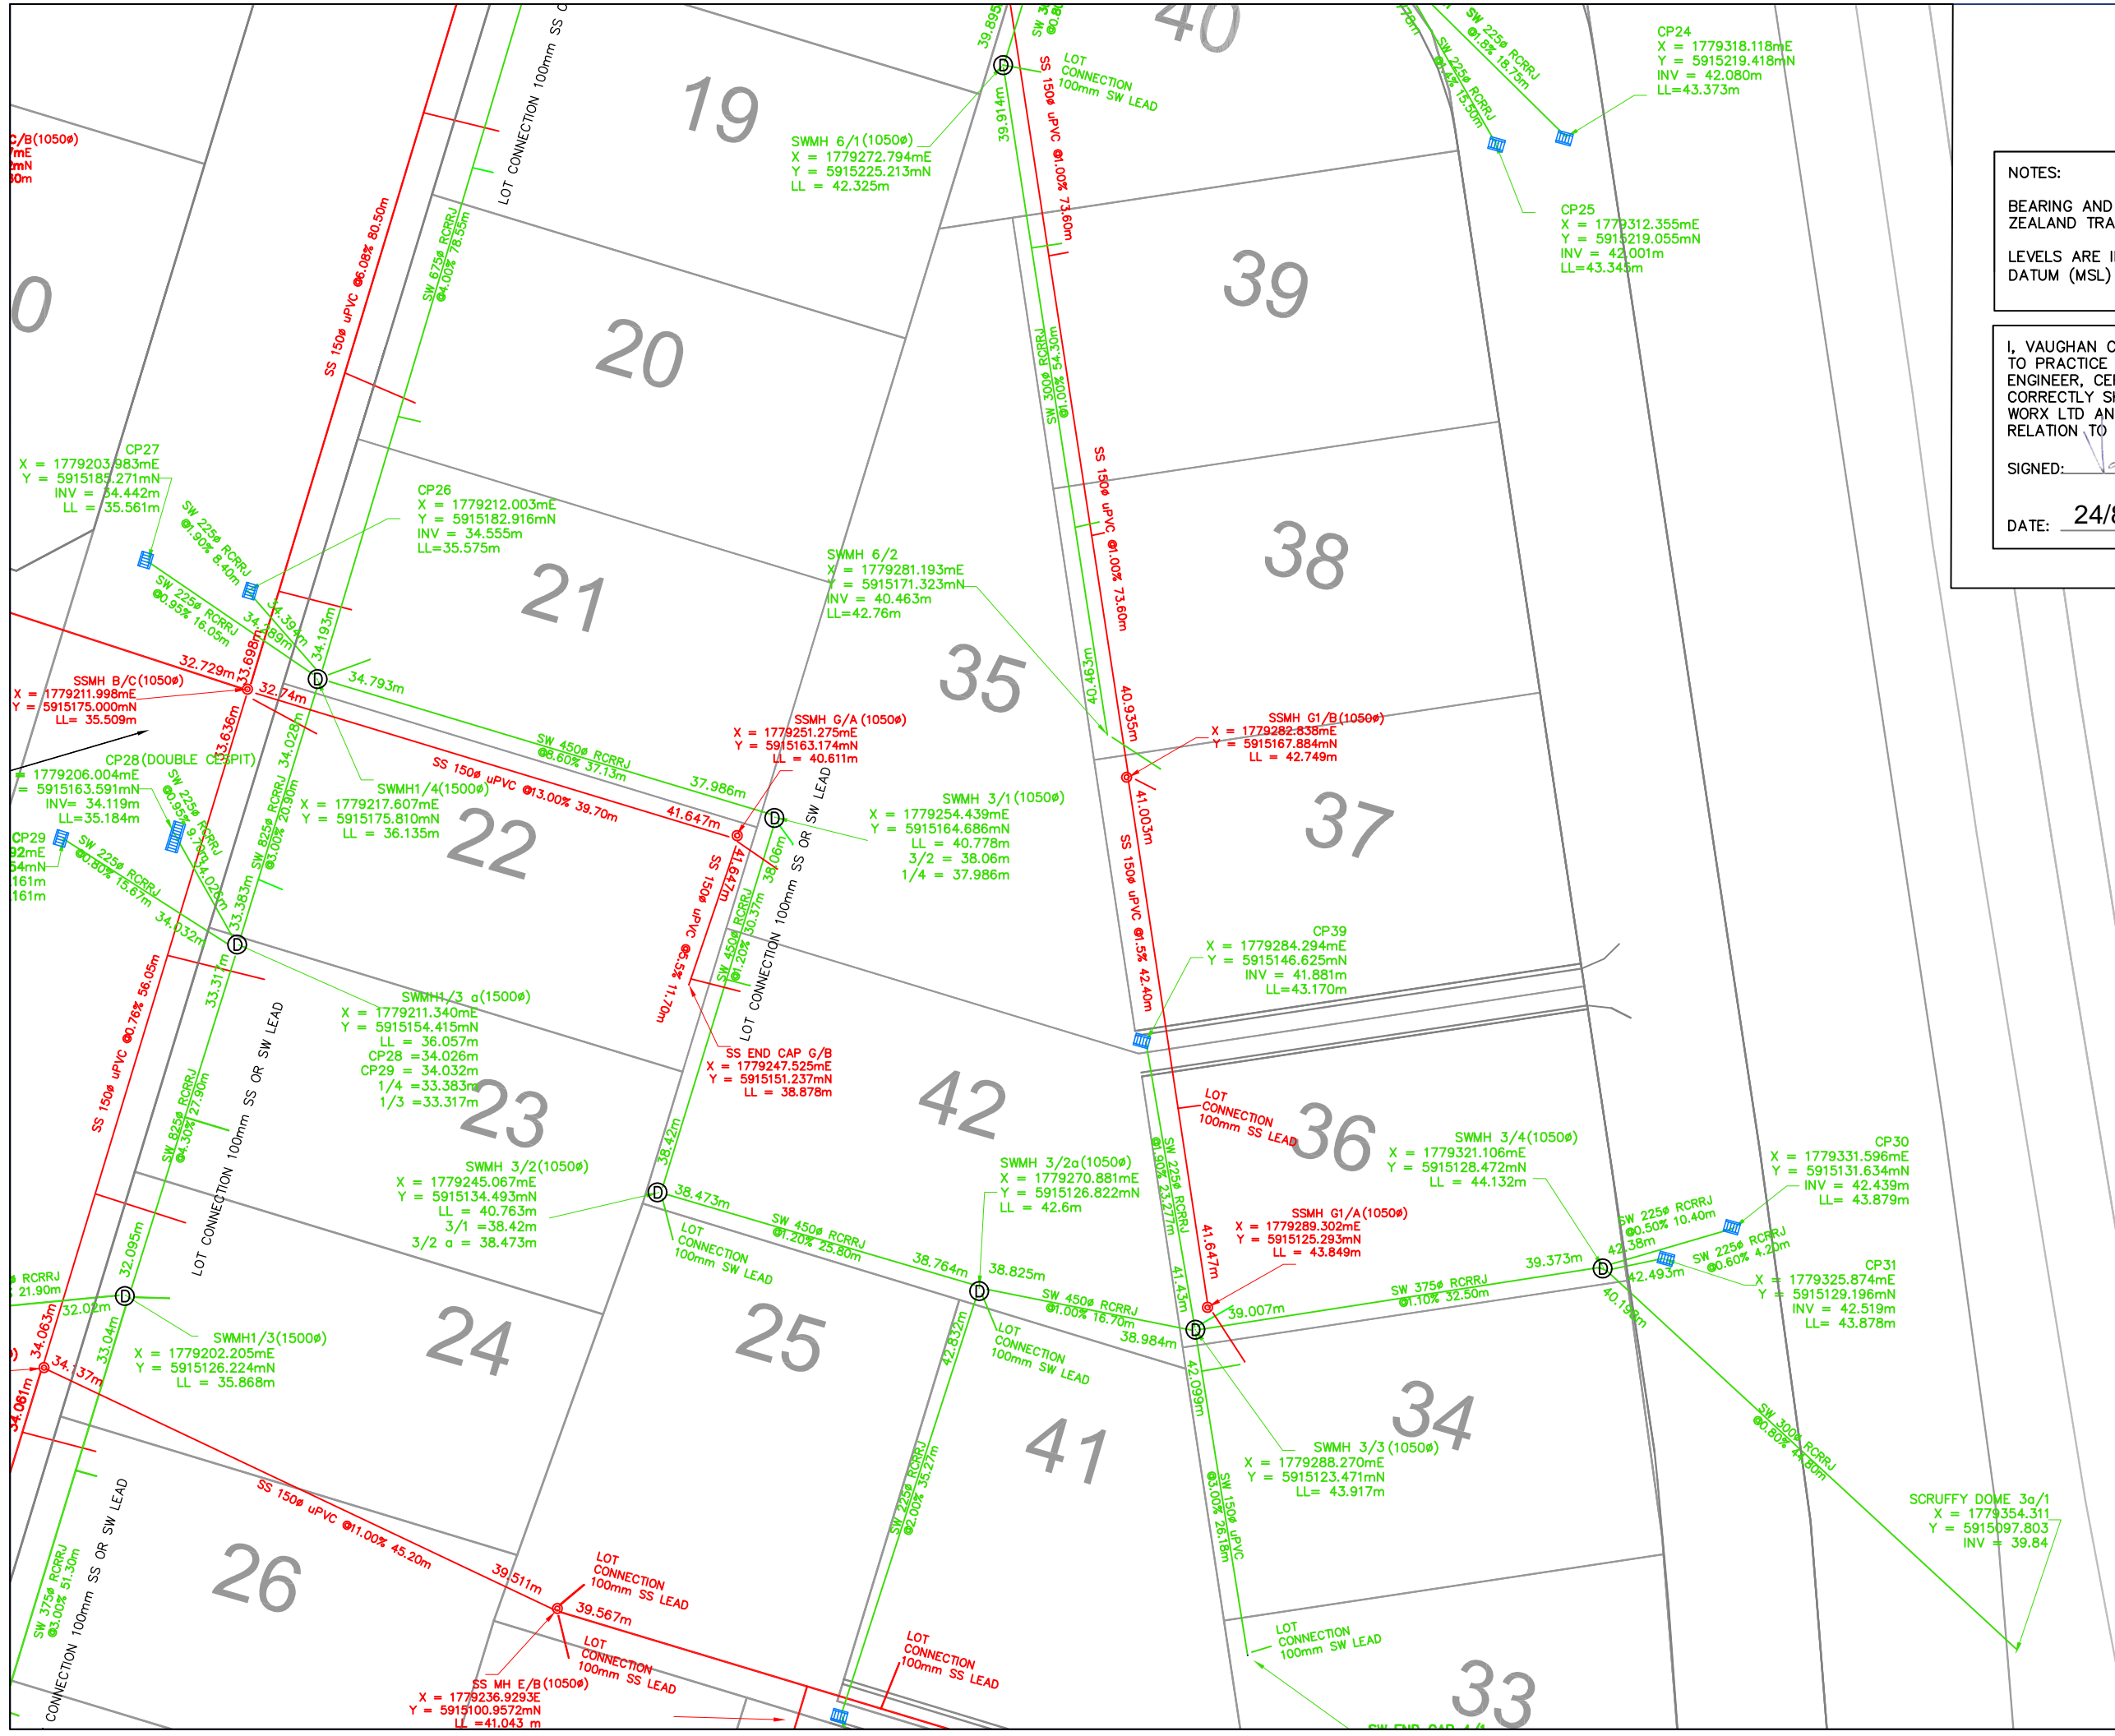

**NOTES:**  
 BEARING AND COORDINATE DATUM IS NEW ZEALAND TRANSVERSE MERCATOR PROJECTION.  
 LEVELS ARE IN TERMS OF LANDS AND SURVEY DATUM (MSL) AUCKLAND 1946.

I, VAUGHAN CRANG, BEING A PERSON ENTITLED TO PRACTICE AS A CHARTED PROFESSIONAL ENGINEER, CERTIFY THE INFORMATION HEREON IS CORRECTLY SHOWN AS SURVEYED BY SURVEY WORX LTD AND ACCURATELY PLOTTED IN RELATION TO THE BOUNDARIES.

SIGNED: *[Signature]*  
 DATE: 24/8/16

REVISION	CHANGES	CHECKED	DATE
A	UPDATED	TL	22/08/16
0	ORIGINAL ISSUE	TL	02/08/16

**COPYRIGHT:**  
 This document and the copyright in this document remain the property of Crang Consulting Ltd. The contents of this document may not be reproduced either in whole or in part by any means whatsoever without the prior written consent of Crang Consulting.

**CRANG CIVIL**  
 CONSULTING ENGINEERS

phone +64 09 281 4979  
 web www.crangcivil.co.nz  
 address Unit 4, 517 Mount Wellington High Way, Auckland  
 post PO Box 42-089, Orakei, Auckland 1745, NZ

CLIENT  
**GRAPHITE MANAGEMENT**

PROJECT  
**BEACHLANDS**

TITLE  
**DRAINAGE AS-BUILT SHEET 4**


DATE	JUNE 2016	SCALE
DRAWN	DW	A1 1:250
DESIGNED		A3 1:500
DRAWING No	as-built drainage	SHEET 4 of 8
REVISION		A



NOTES:  
 BEARING AND COORDINATE DATUM IS NEW ZEALAND TRANSVERSE MERCATOR PROJECTION.  
 LEVELS ARE IN TERMS OF LANDS AND SURVEY DATUM (MSL) AUCKLAND 1946.

I, VAUGHAN CRANG, BEING A PERSON ENTITLED TO PRACTICE AS A CHARTED PROFESSIONAL ENGINEER, CERTIFY THE INFORMATION HEREON IS CORRECTLY SHOWN AS SURVEYED BY SURVEY WORX LTD AND ACCURATELY PLOTTED IN RELATION TO THE BOUNDARIES.

SIGNED: \_\_\_\_\_  
 DATE: 24/8/16

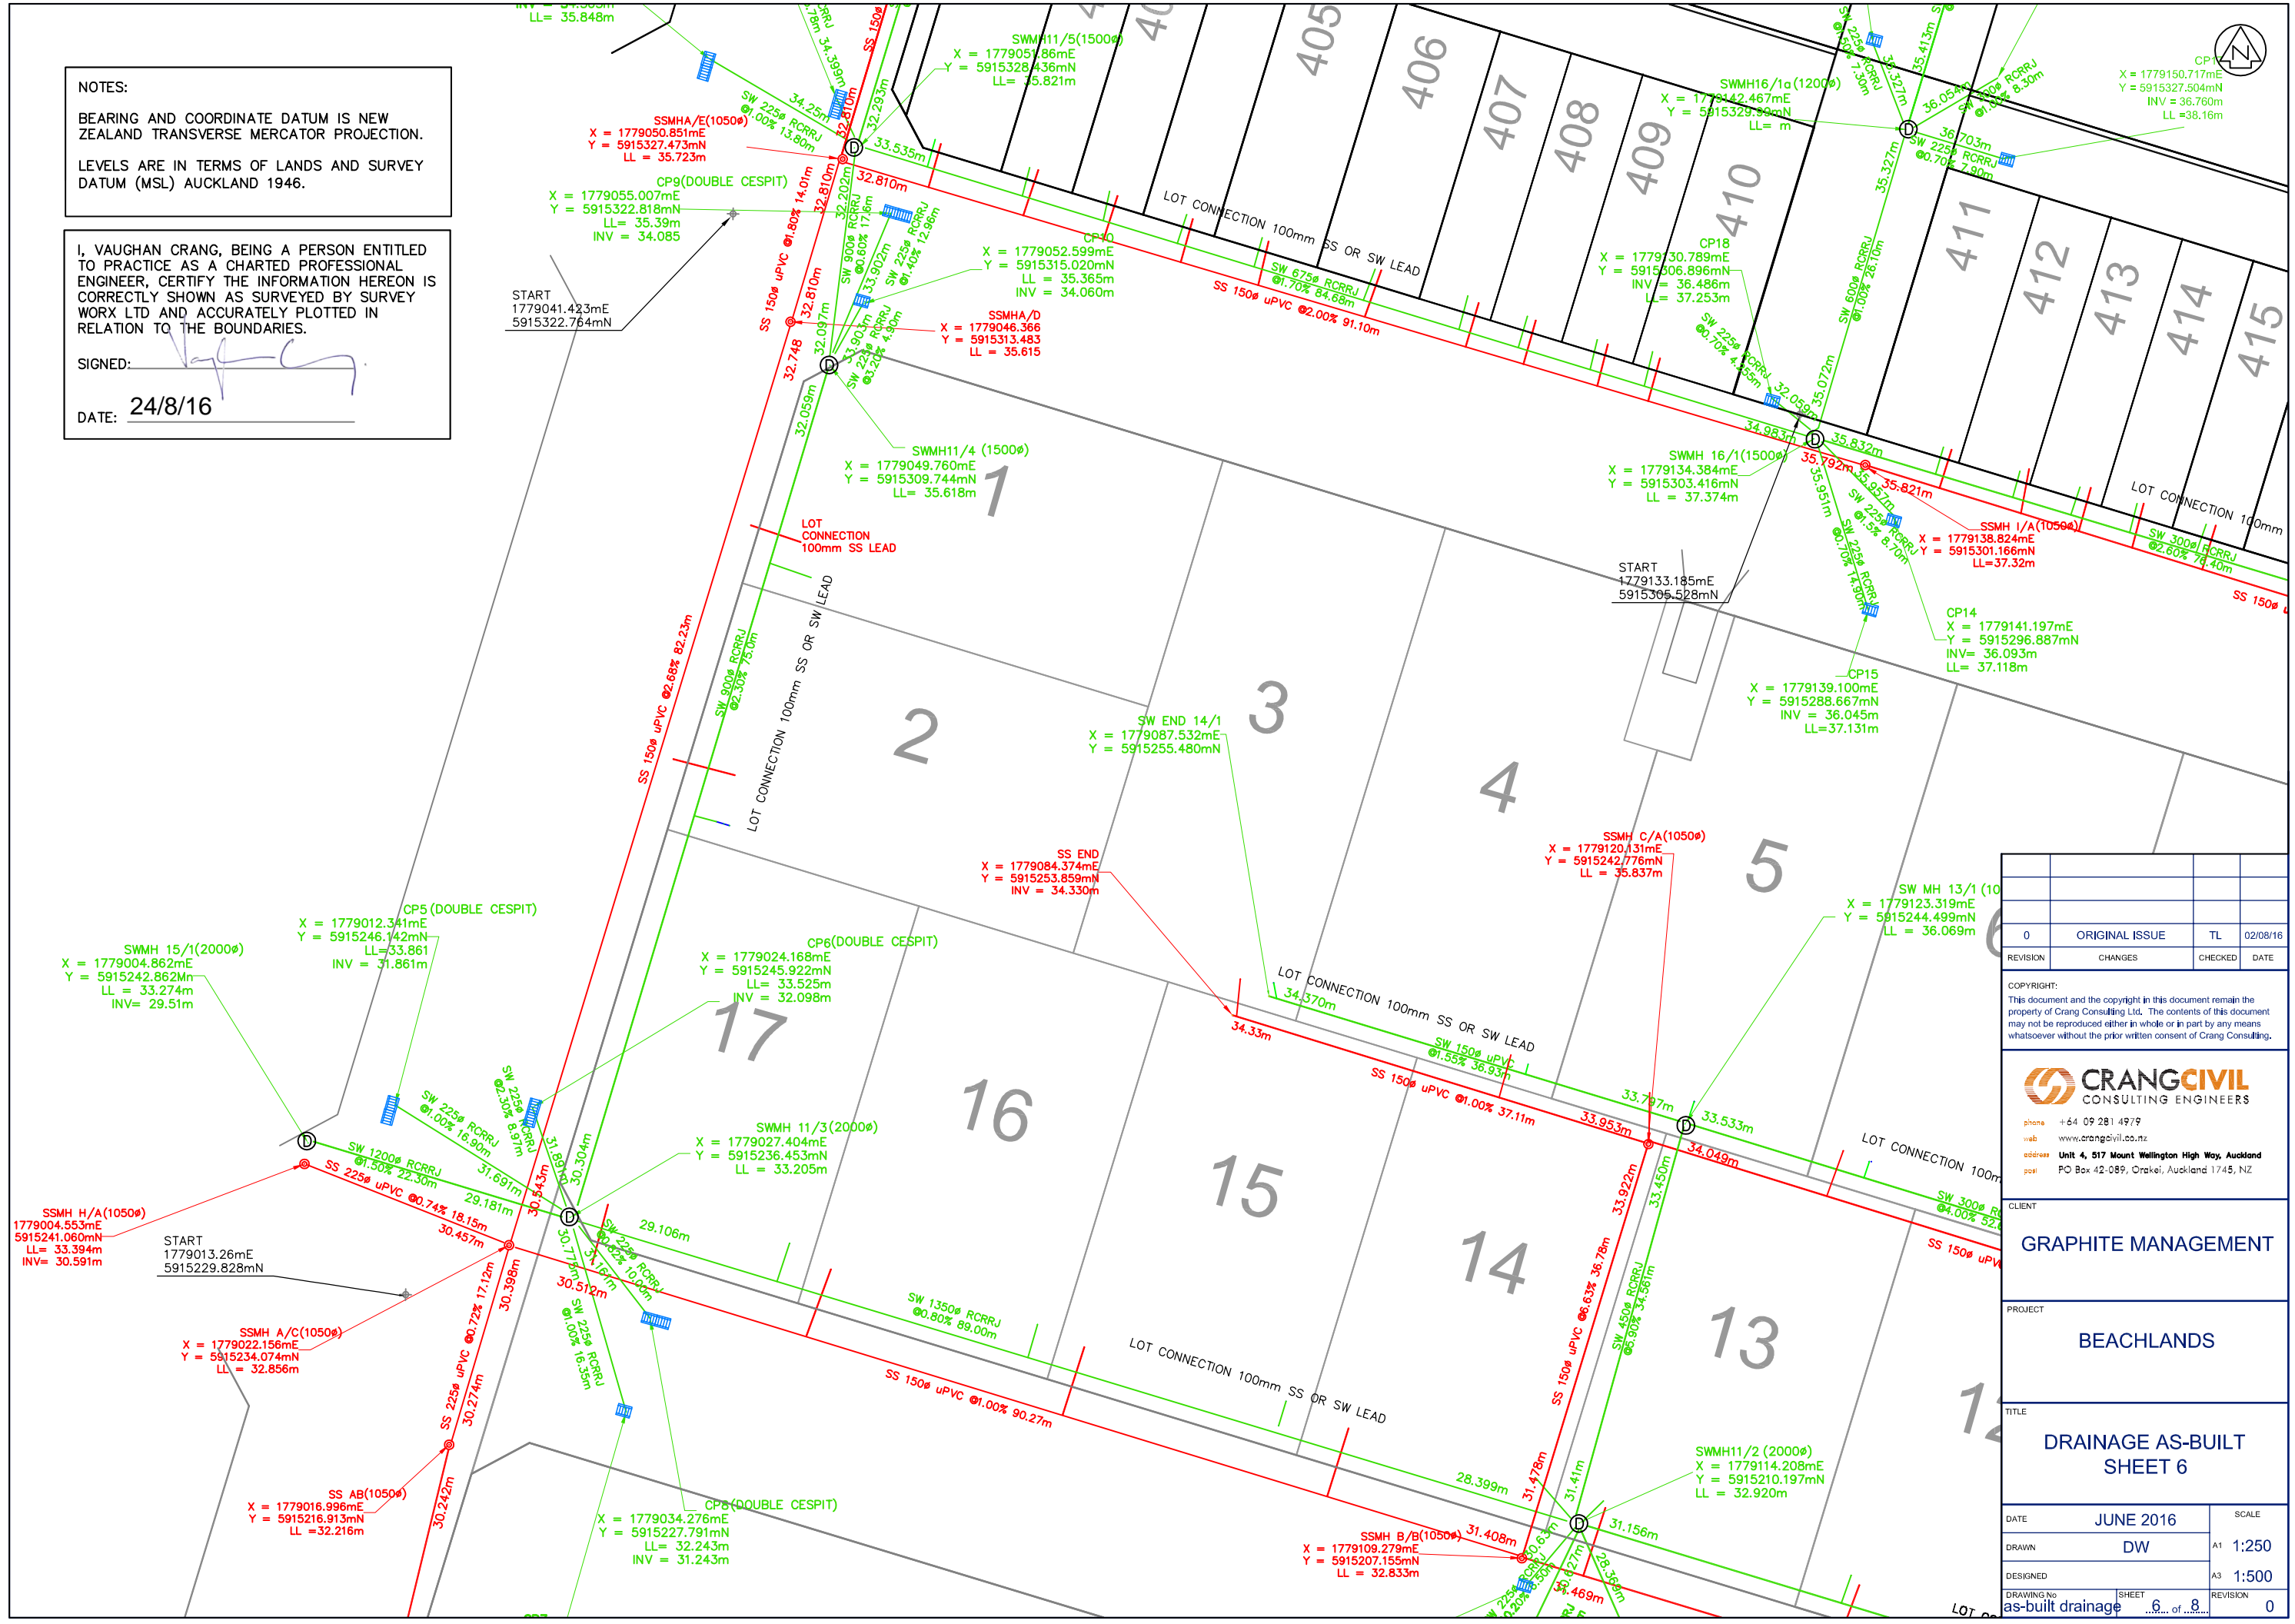

REVISION	CHANGES	CHECKED	DATE
0	ORIGINAL ISSUE	TL	02/08/16

COPYRIGHT:  
 This document and the copyright in this document remain the property of Crang Consulting Ltd. The contents of this document may not be reproduced either in whole or in part by any means whatsoever without the prior written consent of Crang Consulting.

**CRANGCIVIL**  
 CONSULTING ENGINEERS  
 phone +64 09 281 4979  
 web www.crangcivil.co.nz  
 address Unit 4, 517 Mount Wellington High Way, Auckland  
 post PO Box 42-089, Orakei, Auckland 1745, NZ

CLIENT: GRAPHITE MANAGEMENT

PROJECT: BEACHLANDS

TITLE: DRAINAGE AS-BUILT SHEET 6

DATE	JUNE 2016	SCALE
DRAWN	DW	A1 1:250
DESIGNED		A3 1:500
DRAWING No	SHEET	REVISION
as-built drainage	...6... of ...8...	0




NOTES:  
 BEARING AND COORDINATE DATUM IS NEW ZEALAND TRANSVERSE MERCATOR PROJECTION.  
 LEVELS ARE IN TERMS OF LANDS AND SURVEY DATUM (MSL) AUCKLAND 1946.

I, VAUGHAN CRANG, BEING A PERSON ENTITLED TO PRACTICE AS A CHARTED PROFESSIONAL ENGINEER, CERTIFY THE INFORMATION HEREON IS CORRECTLY SHOWN AS SURVEYED BY SURVEY WORX LTD AND ACCURATELY PLOTTED IN RELATION TO THE BOUNDARIES.

SIGNED:   
 DATE: 24/8/16

STAGE 3  
 STAGE 2

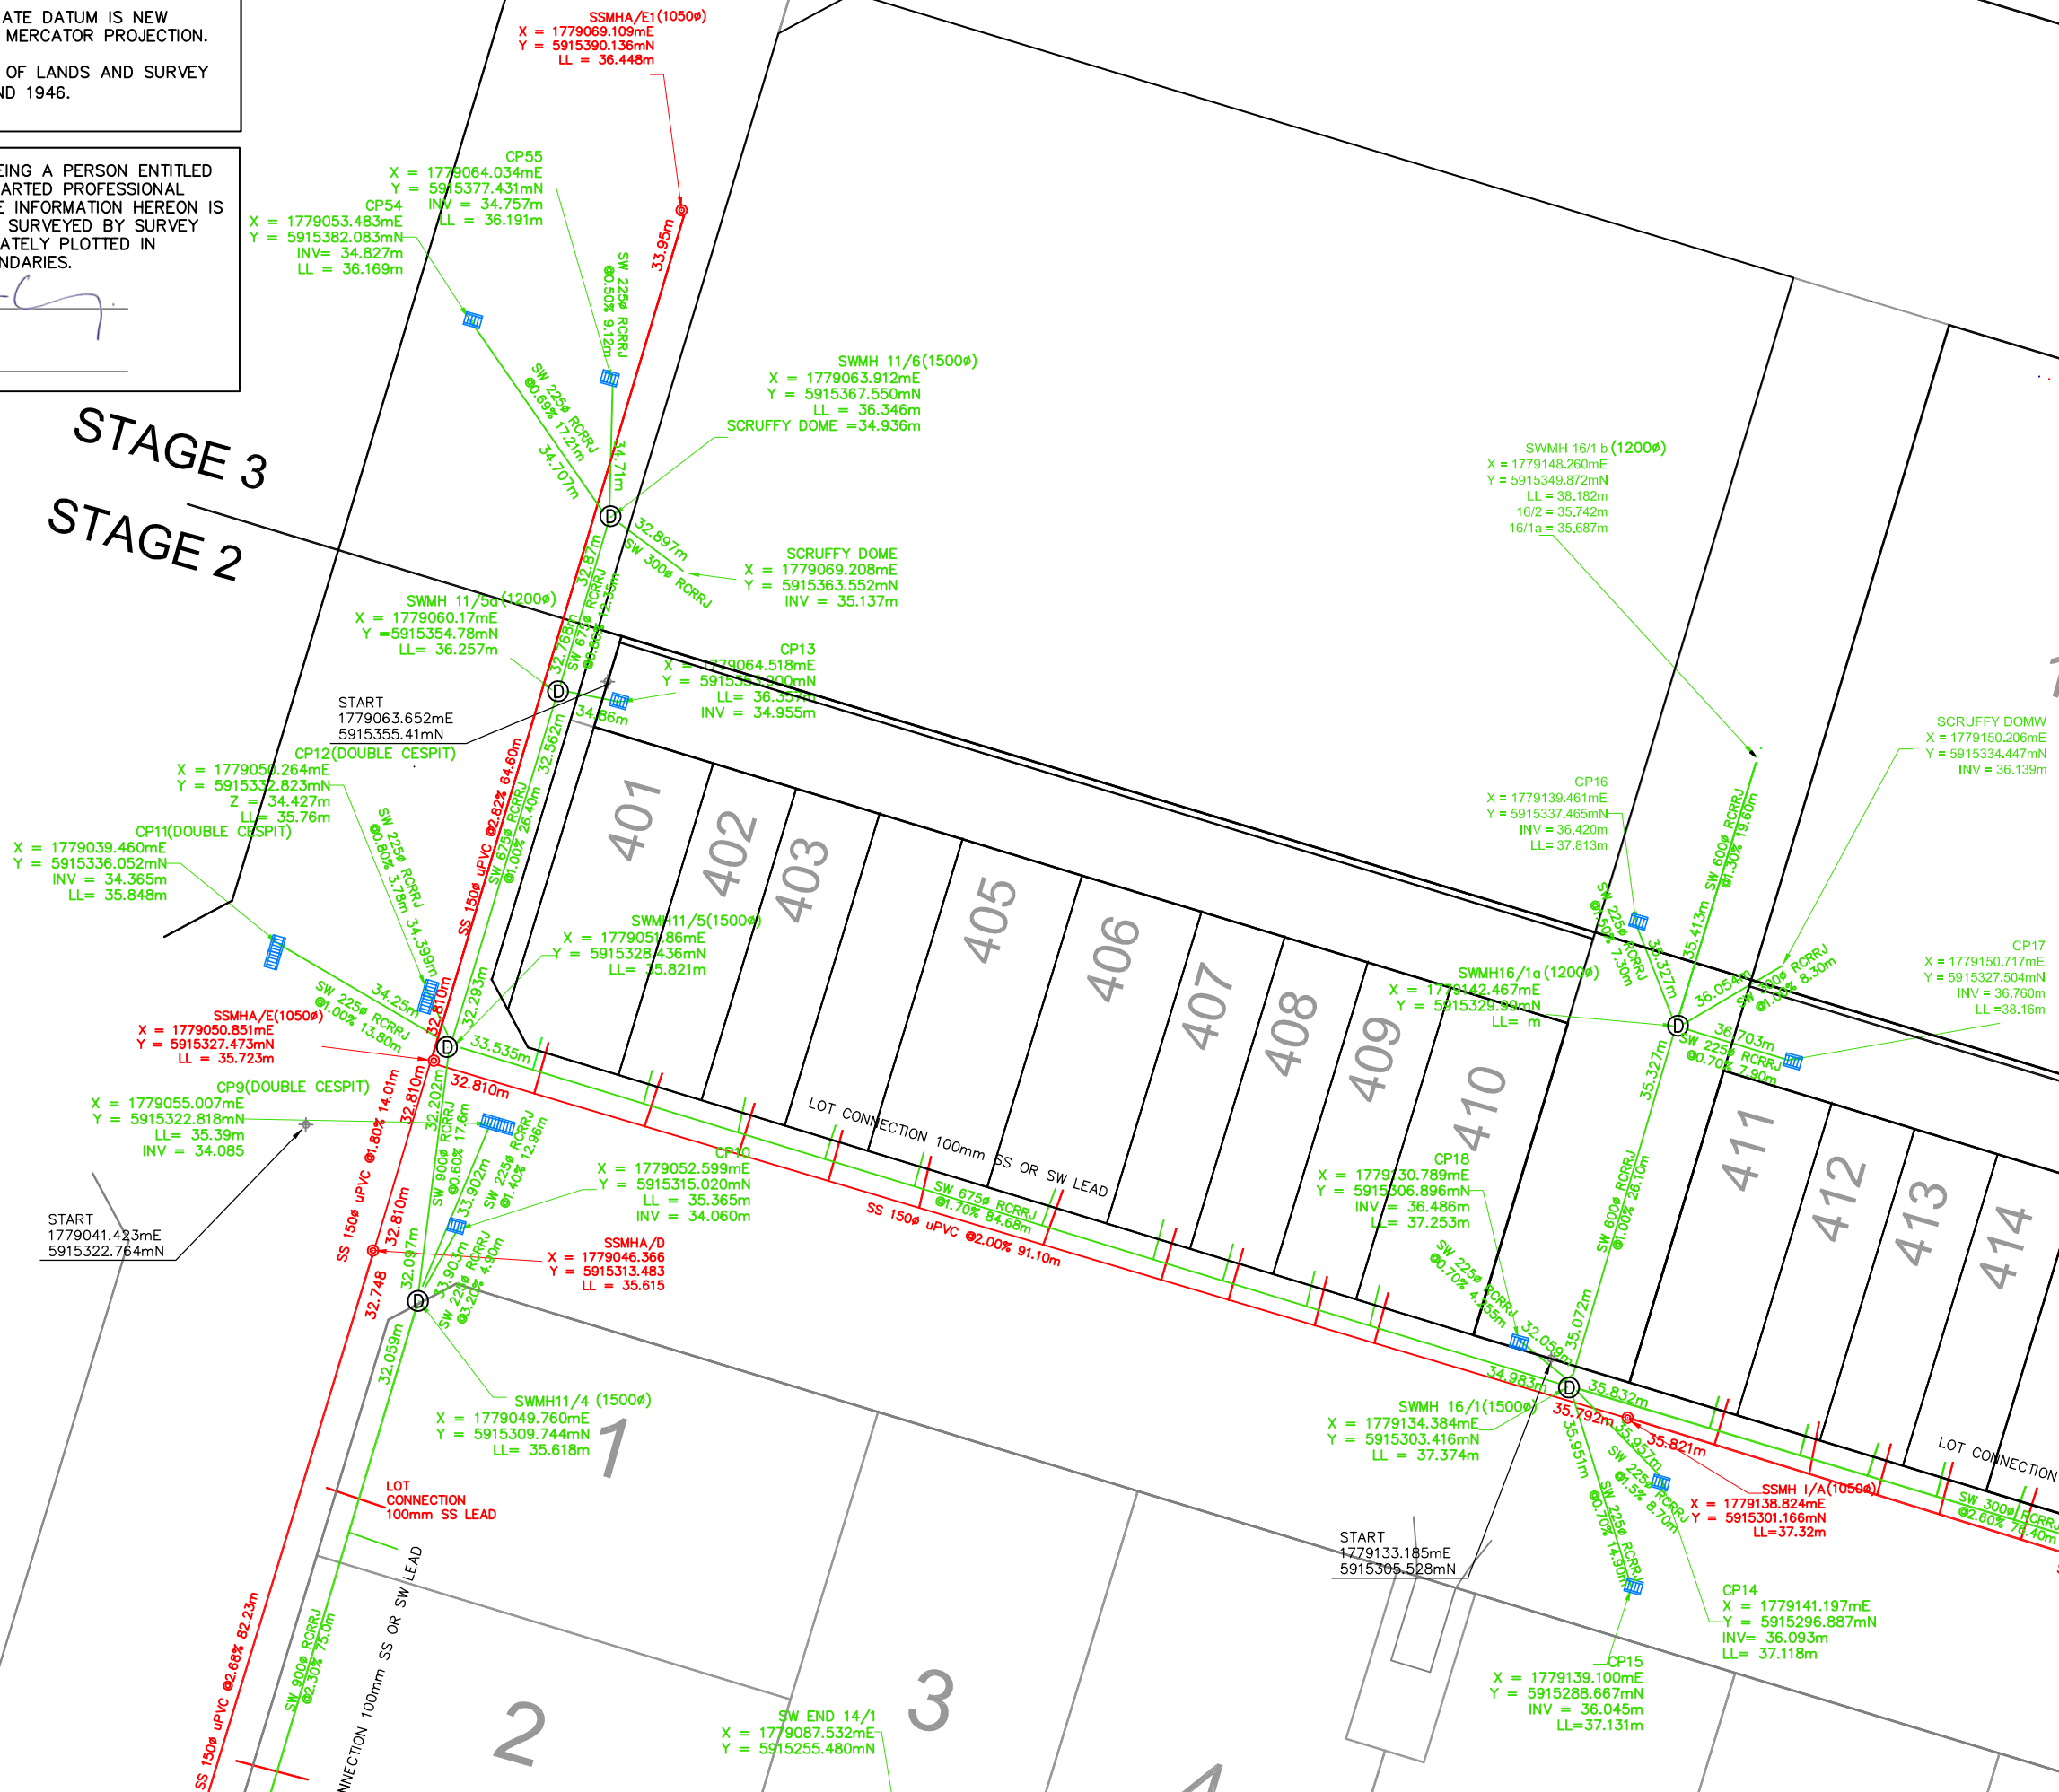

1002

REVISION	CHANGES	CHECKED	DATE
0	ORIGINAL ISSUE	TL	02/08/16

COPYRIGHT:  
 This document and the copyright in this document remain the property of Crang Consulting Ltd. The contents of this document may not be reproduced either in whole or in part by any means whatsoever without the prior written consent of Crang Consulting.

**CRANGCIVIL**  
 CONSULTING ENGINEERS

phone +64 09 281 4979  
 web www.crangcivil.co.nz  
 address Unit 4, 517 Mount Wellington High Way, Auckland  
 post PO Box 42-089, Orakei, Auckland 1745, NZ

CLIENT  
**GRAPHITE MANAGEMENT**

PROJECT  
**BEACHLANDS**

TITLE  
**DRAINAGE AS-BUILT SHEET 7**


DATE	JUNE 2016	SCALE
DRAWN	DW	A1 1:250
DESIGNED		A3 1:500
DRAWING No	SHEET	REVISION
as-built drainage	7 of 8	0



NOTES:  
 BEARING AND COORDINATE DATUM IS NEW ZEALAND TRANSVERSE MERCATOR PROJECTION.  
 LEVELS ARE IN TERMS OF LANDS AND SURVEY DATUM (MSL) AUCKLAND 1946.

I, VAUGHAN CRANG, BEING A PERSON ENTITLED TO PRACTICE AS A CHARTED PROFESSIONAL ENGINEER, CERTIFY THE INFORMATION HEREON IS CORRECTLY SHOWN AS SURVEYED BY SURVEY WORX LTD AND ACCURATELY PLOTTED IN RELATION TO THE BOUNDARIES.

SIGNED:   
 DATE: 24/8/16

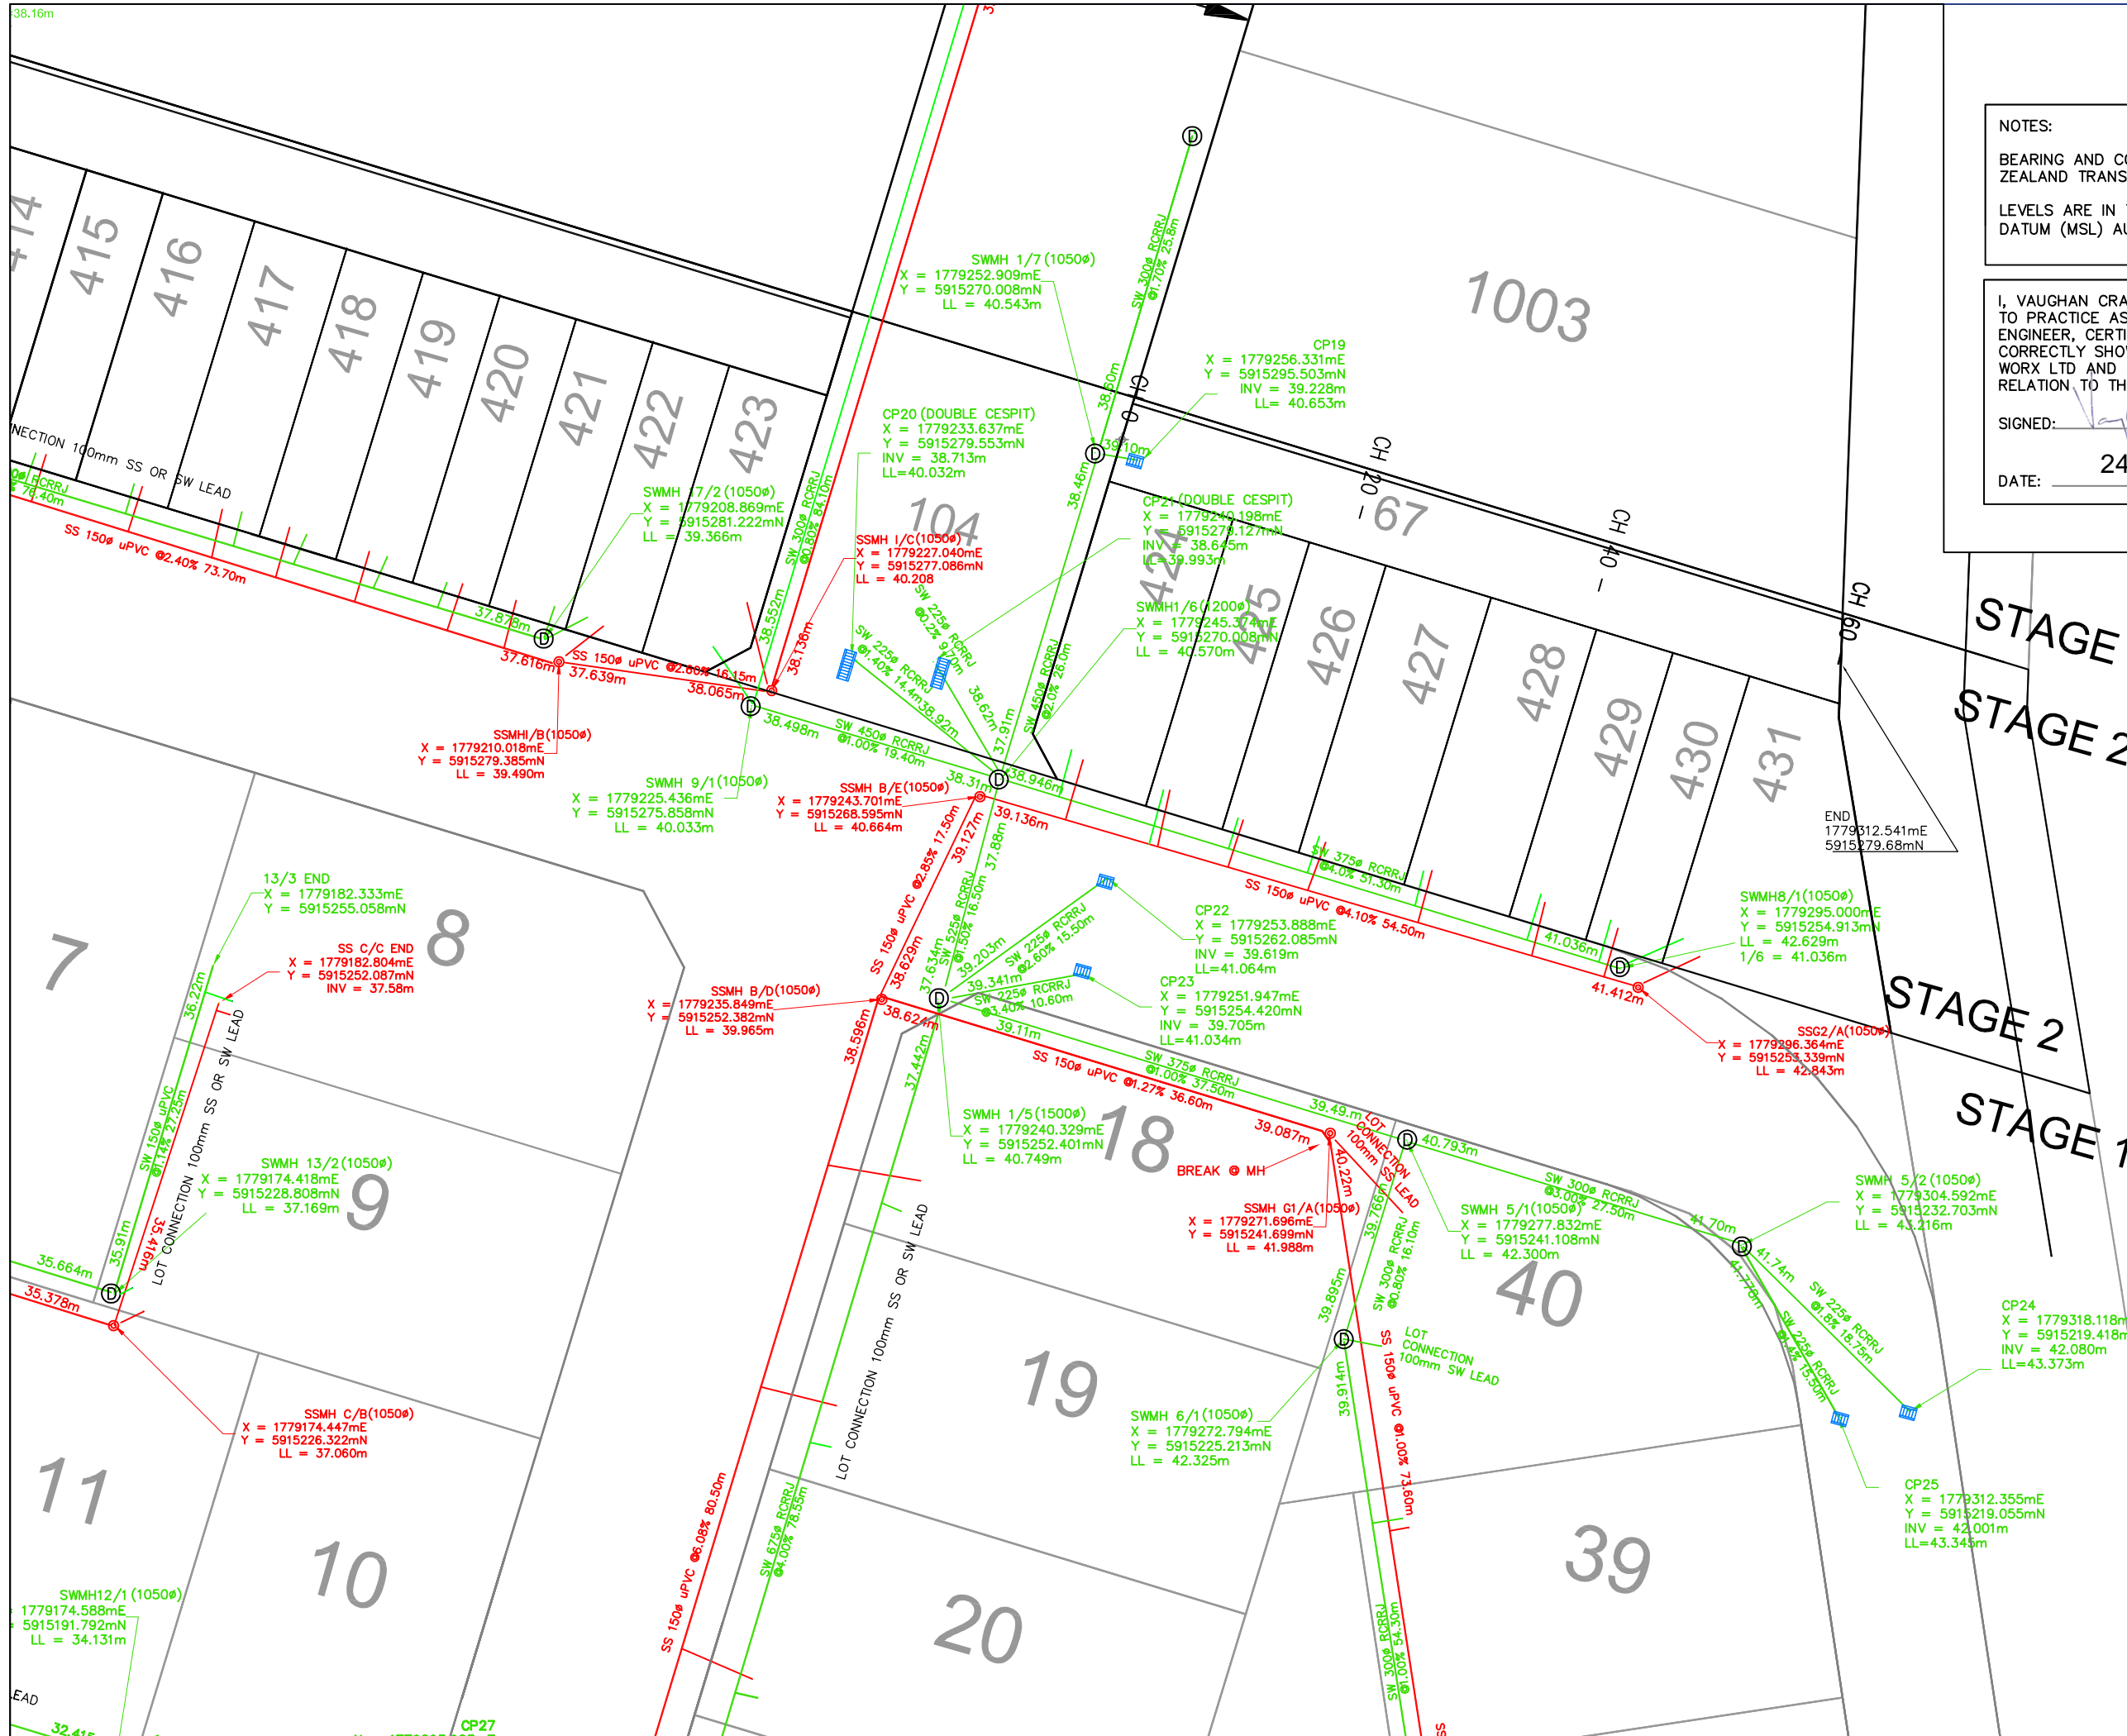

REVISION	CHANGES	CHECKED	DATE
0	ORIGINAL ISSUE	TL	14/07/16

COPYRIGHT:  
 This document and the copyright in this document remain the property of Crang Consulting Ltd. The contents of this document may not be reproduced either in whole or in part by any means whatsoever without the prior written consent of Crang Consulting.

**CRANG CIVIL**  
 CONSULTING ENGINEERS  
 phone +64 09 281 4979  
 web www.crangcivil.co.nz  
 address Unit 4, 517 Mount Wellington High Way, Auckland  
 post PO Box 42-089, Orakei, Auckland 1745, NZ


CLIENT  
**GRAPHITE MANAGEMENT**

PROJECT  
**BEACHLANDS**

TITLE  
**DRAINAGE AS-BUILT SHEET 8**

DATE	JUNE 2016	SCALE
DRAWN	DW	A1 1:250
DESIGNED		A3 1:500
DRAWING No	as-built drainage	SHEET
	8 of 8	REVISION
		0



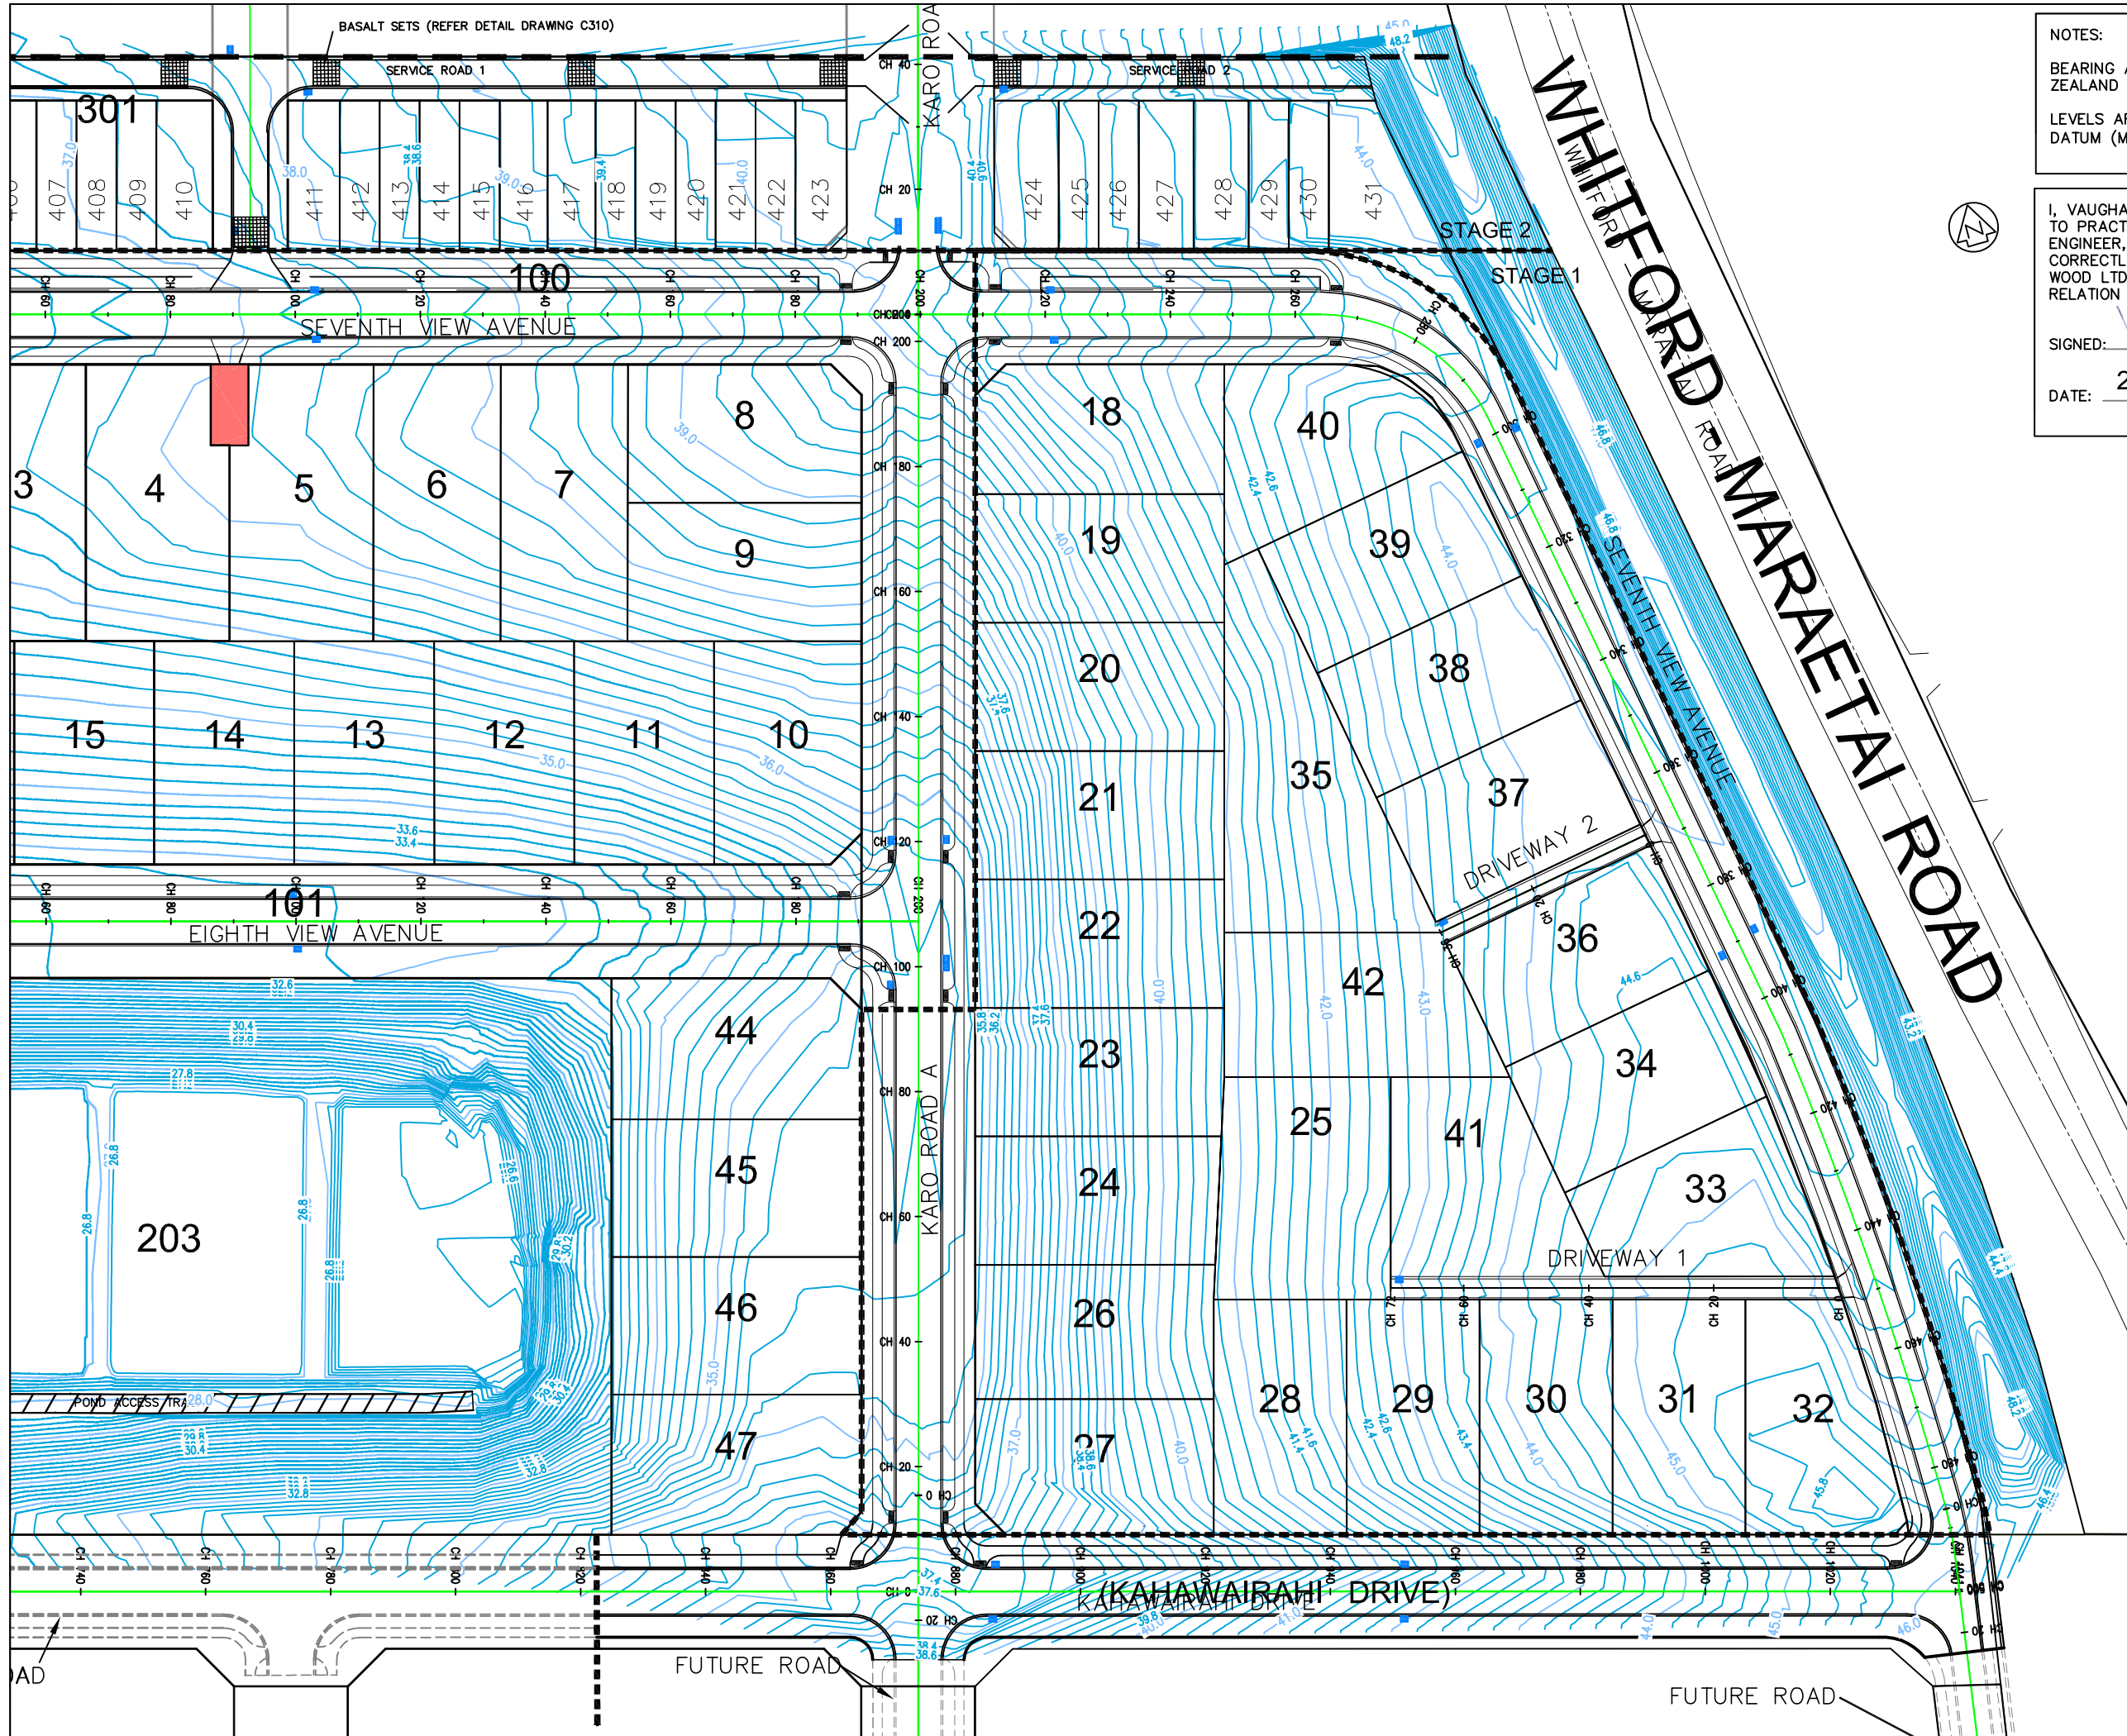

NOTES:  
 BEARING AND COORDINATE DATUM IS NEW ZEALAND TRANSVERSE MERCATOR PROJECTION.  
 LEVELS ARE IN TERMS OF LANDS AND SURVEY DATUM (MSL) AUCKLAND 1946.

I, VAUGHAN CRANG, BEING A PERSON ENTITLED TO PRACTICE AS A CHARTED PROFESSIONAL ENGINEER, CERTIFY THE INFORMATION HEREON IS CORRECTLY SHOWN AS SURVEYED BY DEMPSEY WOOD LTD AND ACCURATELY PLOTTED IN RELATION TO THE BOUNDARIES.

SIGNED: *[Signature]*  
 DATE: 24/8/16

REVISION	CHANGES	CHECKED	DATE
0	ORIGINAL ISSUE	TL	02/08/15

COPYRIGHT:  
 This document and the copyright in this document remain the property of Crang Consulting Ltd. The contents of this document may not be reproduced either in whole or in part by any means whatsoever without the prior written consent of Crang Consulting.

**CRANG CIVIL**  
 CONSULTING ENGINEERS

phone +64 09 281 4979  
 web www.crangcivil.co.nz  
 address 6 Aranui Road, Sylvia Park, Auckland, NZ  
 post PO Box 42-089, Orakei, Auckland 1745, NZ

CLIENT  
**GRAPHITE MANAGEMENT**

PROJECT  
**BEACHLANDS**

TITLE  
**STAGE 1 & 2 FINISHED CONTOURS SHEET 1**

DATE	FEB 2015	SCALE	A1 1:500
DRAWN	DW	A3 1:1000	
DESIGNED		REVISION	0
DRAWING No	as-built roading	SHEET	1 of 2



103

BASALT SETS (REFER DETAIL DRAWING C310)

SERVICE ROAD 1

SERVICE ROAD 2

STAGE 2

STAGE 1

301

100

SEVENTH VIEW AVENUE

KARO ROAD E

1

2

3

4

5

6

7

8

9

18

40

19

20

21

35

17

16

15

14

13

12

11

10

101

EIGHTH VIEW AVENUE

MAHUTONGA AVE

KARO ROAD A

203

44

45

46

47

200

POND ACCESS TRAIL

TRAHI DRIVE


EXISTING ROAD

FUTURE ROAD

FUTURE ROAD

NOTES:  
 BEARING AND COORDINATE DATUM IS NEW ZEALAND TRANSVERSE MERCATOR PROJECTION.  
 LEVELS ARE IN TERMS OF LANDS AND SURVEY DATUM (MSL) AUCKLAND 1946.

I, VAUGHAN CRANG, BEING A PERSON ENTITLED TO PRACTICE AS A CHARTED PROFESSIONAL ENGINEER, CERTIFY THE INFORMATION HEREON IS CORRECTLY SHOWN AS SURVEYED BY DEMPSEY WOOD LTD AND ACCURATELY PLOTTED IN RELATION TO THE BOUNDARIES.

SIGNED:   
 DATE: 24/8/16

REVISION	CHANGES	CHECKED	DATE
0	ORIGINAL ISSUE	TL	02/08/15

COPYRIGHT:  
 This document and the copyright in this document remain the property of Crang Consulting Ltd. The contents of this document may not be reproduced either in whole or in part by any means whatsoever without the prior written consent of Crang Consulting.

**CRANG CIVIL**  
 CONSULTING ENGINEERS  
 phone +64 09 281 4979  
 web www.crangcivil.co.nz  
 address 6 Aranui Road, Sylvia Park, Auckland, NZ  
 post PO Box 42-089, Orakei, Auckland 1745, NZ

CLIENT  
**GRAPHITE MANAGEMENT**

PROJECT  
**BEACHLANDS**


TITLE  
**STAGE 1 & 2 FINISHED CONTOURS SHEET 2**

DATE	SCALE
FEB 2015	A1 1:500
DRAWN DW	A3 1:1000
DESIGNED	REVISION
DRAWING No as-built roading	SHEET 2 of 2
	REVISION 0

NOTES:  
 BEARING AND COORDINATE DATUM IS NEW ZEALAND TRANSVERSE MERCATOR PROJECTION.  
 LEVELS ARE IN TERMS OF LANDS AND SURVEY DATUM (MSL) AUCKLAND 1946.

I, VAUGHAN CRANG, BEING A PERSON ENTITLED TO PRACTICE AS A CHARTED PROFESSIONAL ENGINEER, CERTIFY THE INFORMATION HEREON IS CORRECTLY SHOWN AS SURVEYED BY SURVEY WORX LTD AND ACCURATELY PLOTTED IN RELATION TO THE BOUNDARIES.

SIGNED: \_\_\_\_\_  
 DATE: 24/8/16

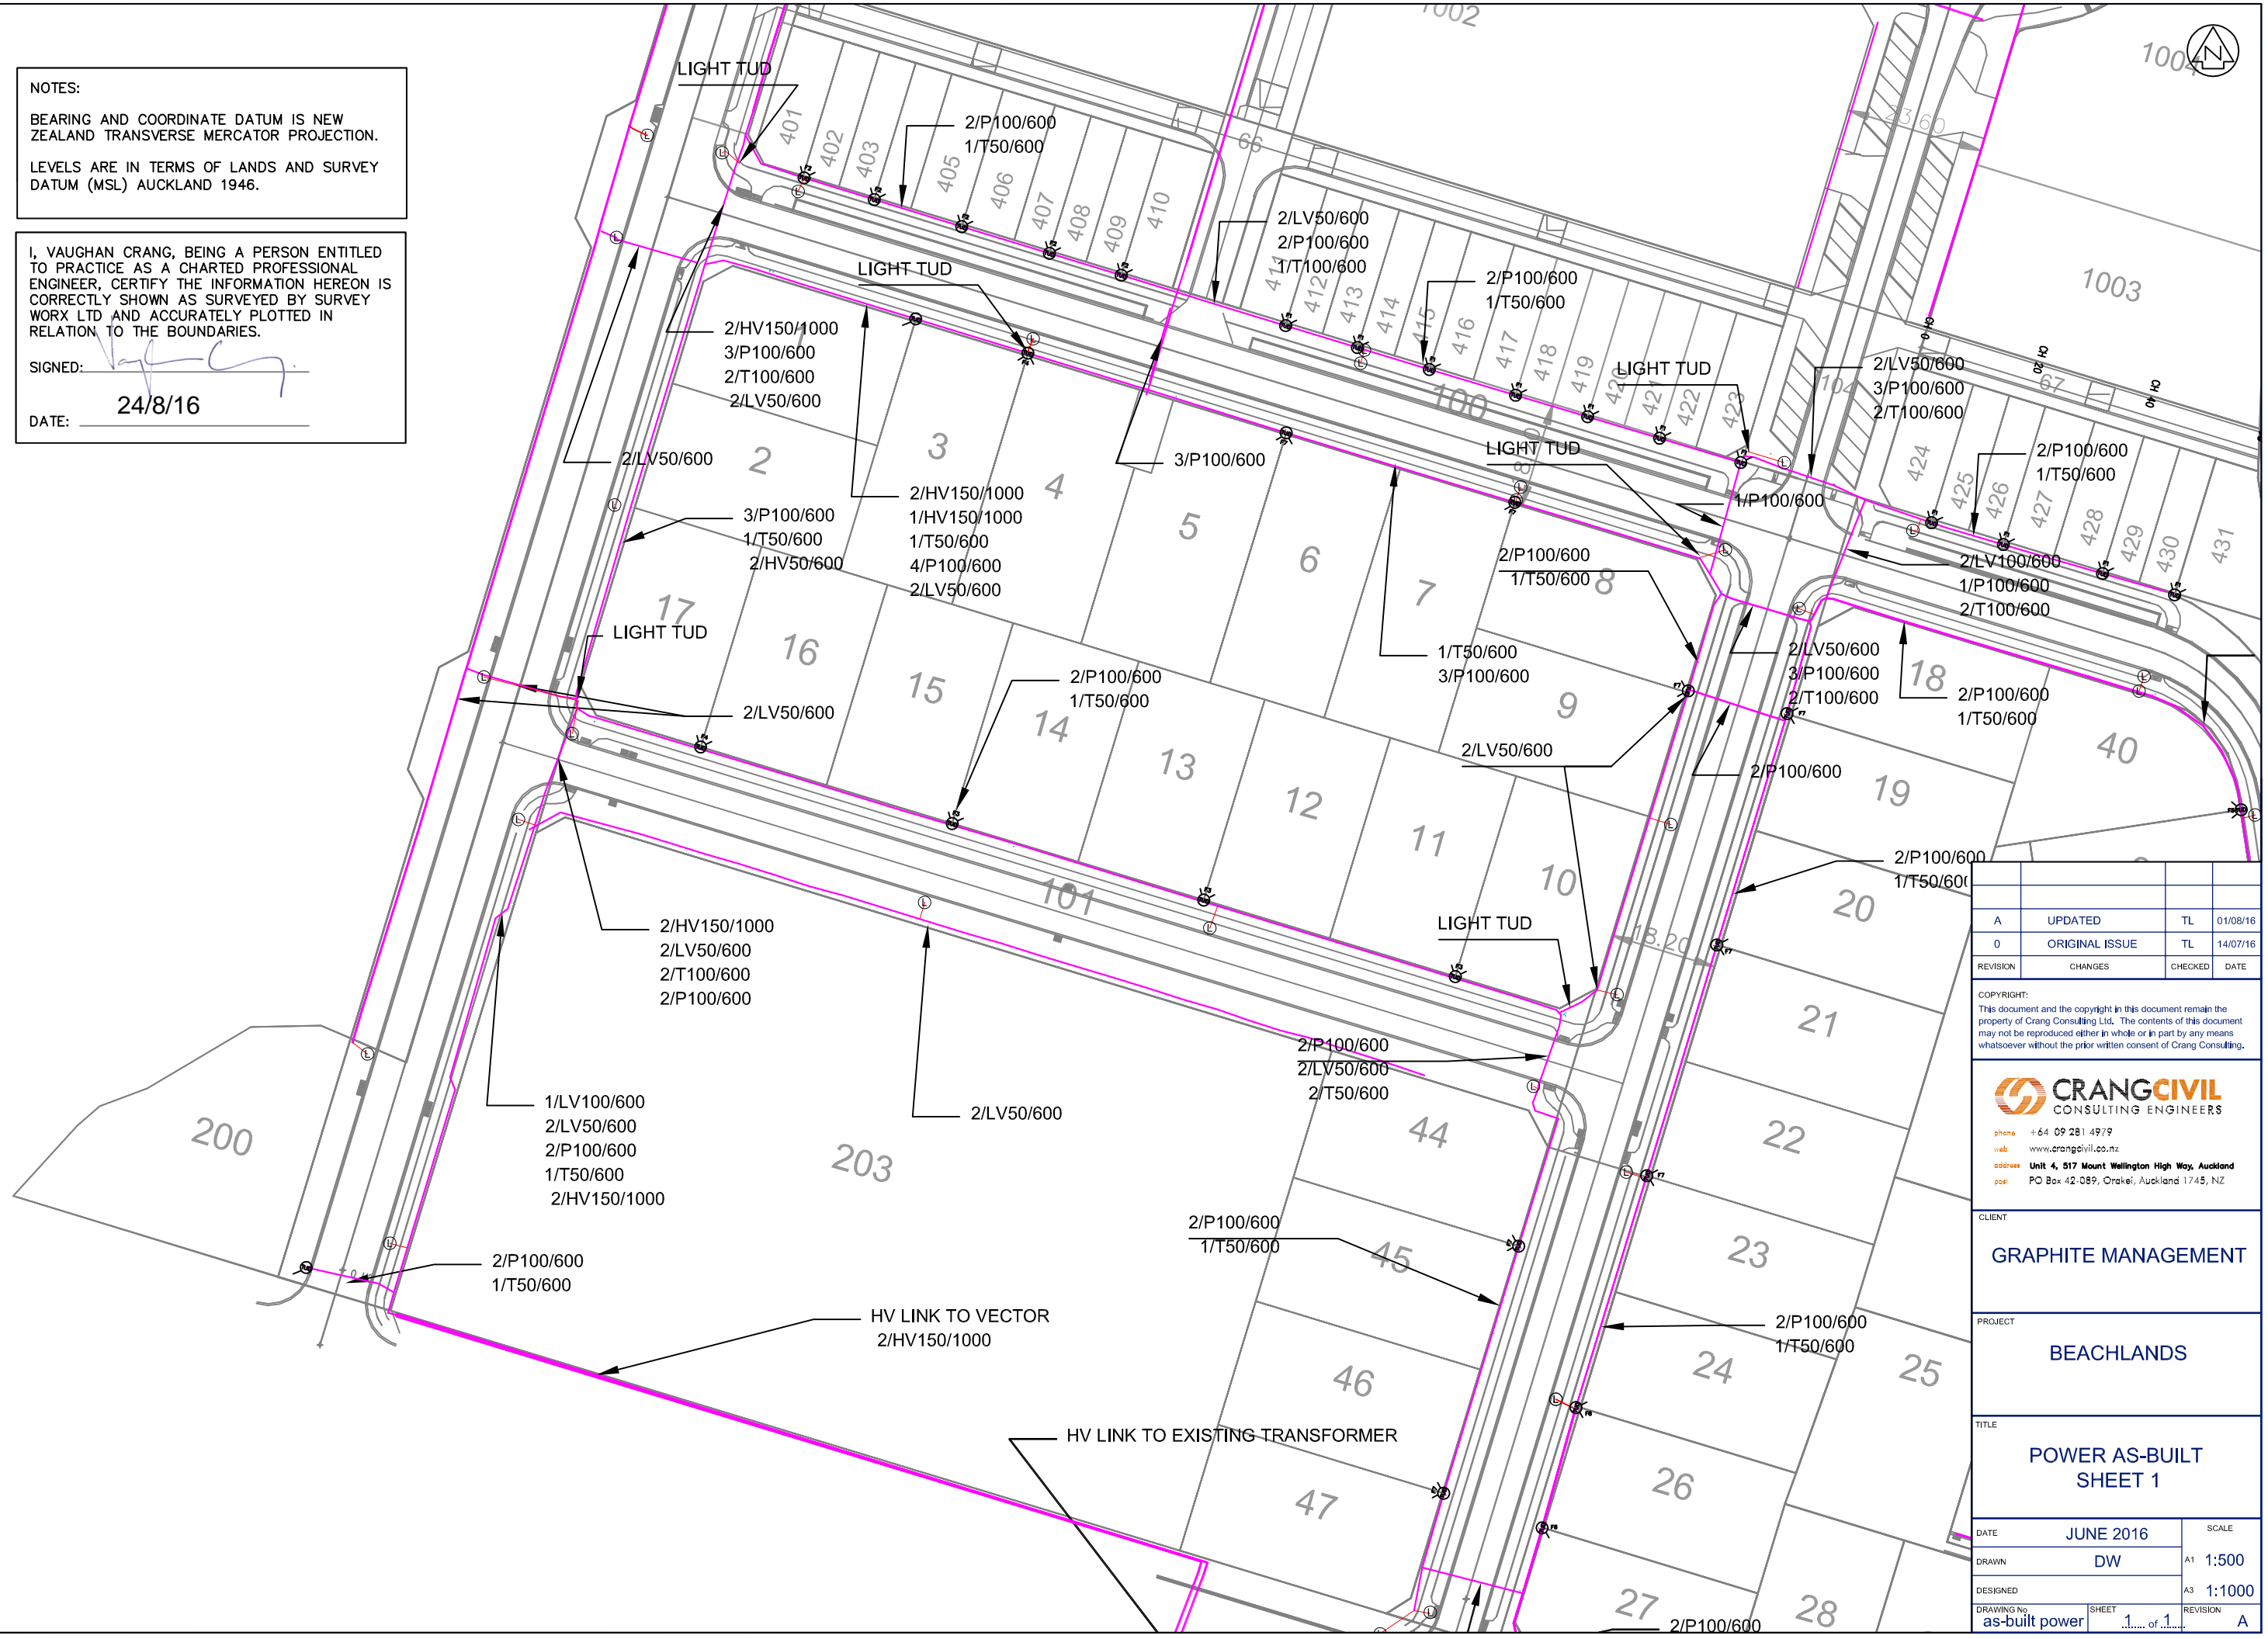

REVISION	CHANGES	CHECKED	DATE
A	UPDATED	TL	01/08/16
0	ORIGINAL ISSUE	TL	14/07/16

COPYRIGHT:  
 This document and the copyright in this document remain the property of Crang Consulting Ltd. The contents of this document may not be reproduced either in whole or in part by any means whatsoever without the prior written consent of Crang Consulting.

**CRANG CIVIL**  
 CONSULTING ENGINEERS


phone +64 09 281 4979  
 web www.crangcivil.co.nz  
 address Unit 4, 517 Mount Wellington High Way, Auckland  
 post PO Box 42-089, Orakei, Auckland 1745, NZ

CLIENT  
**GRAPHITE MANAGEMENT**

PROJECT  
**BEACHLANDS**

TITLE  
**POWER AS-BUILT SHEET 1**

DATE	JUNE 2016	SCALE	A1 1:500
DRAWN	DW	A3	1:1000
DRAWING No	as-built power	SHEET	1 of 1
REVISION			A

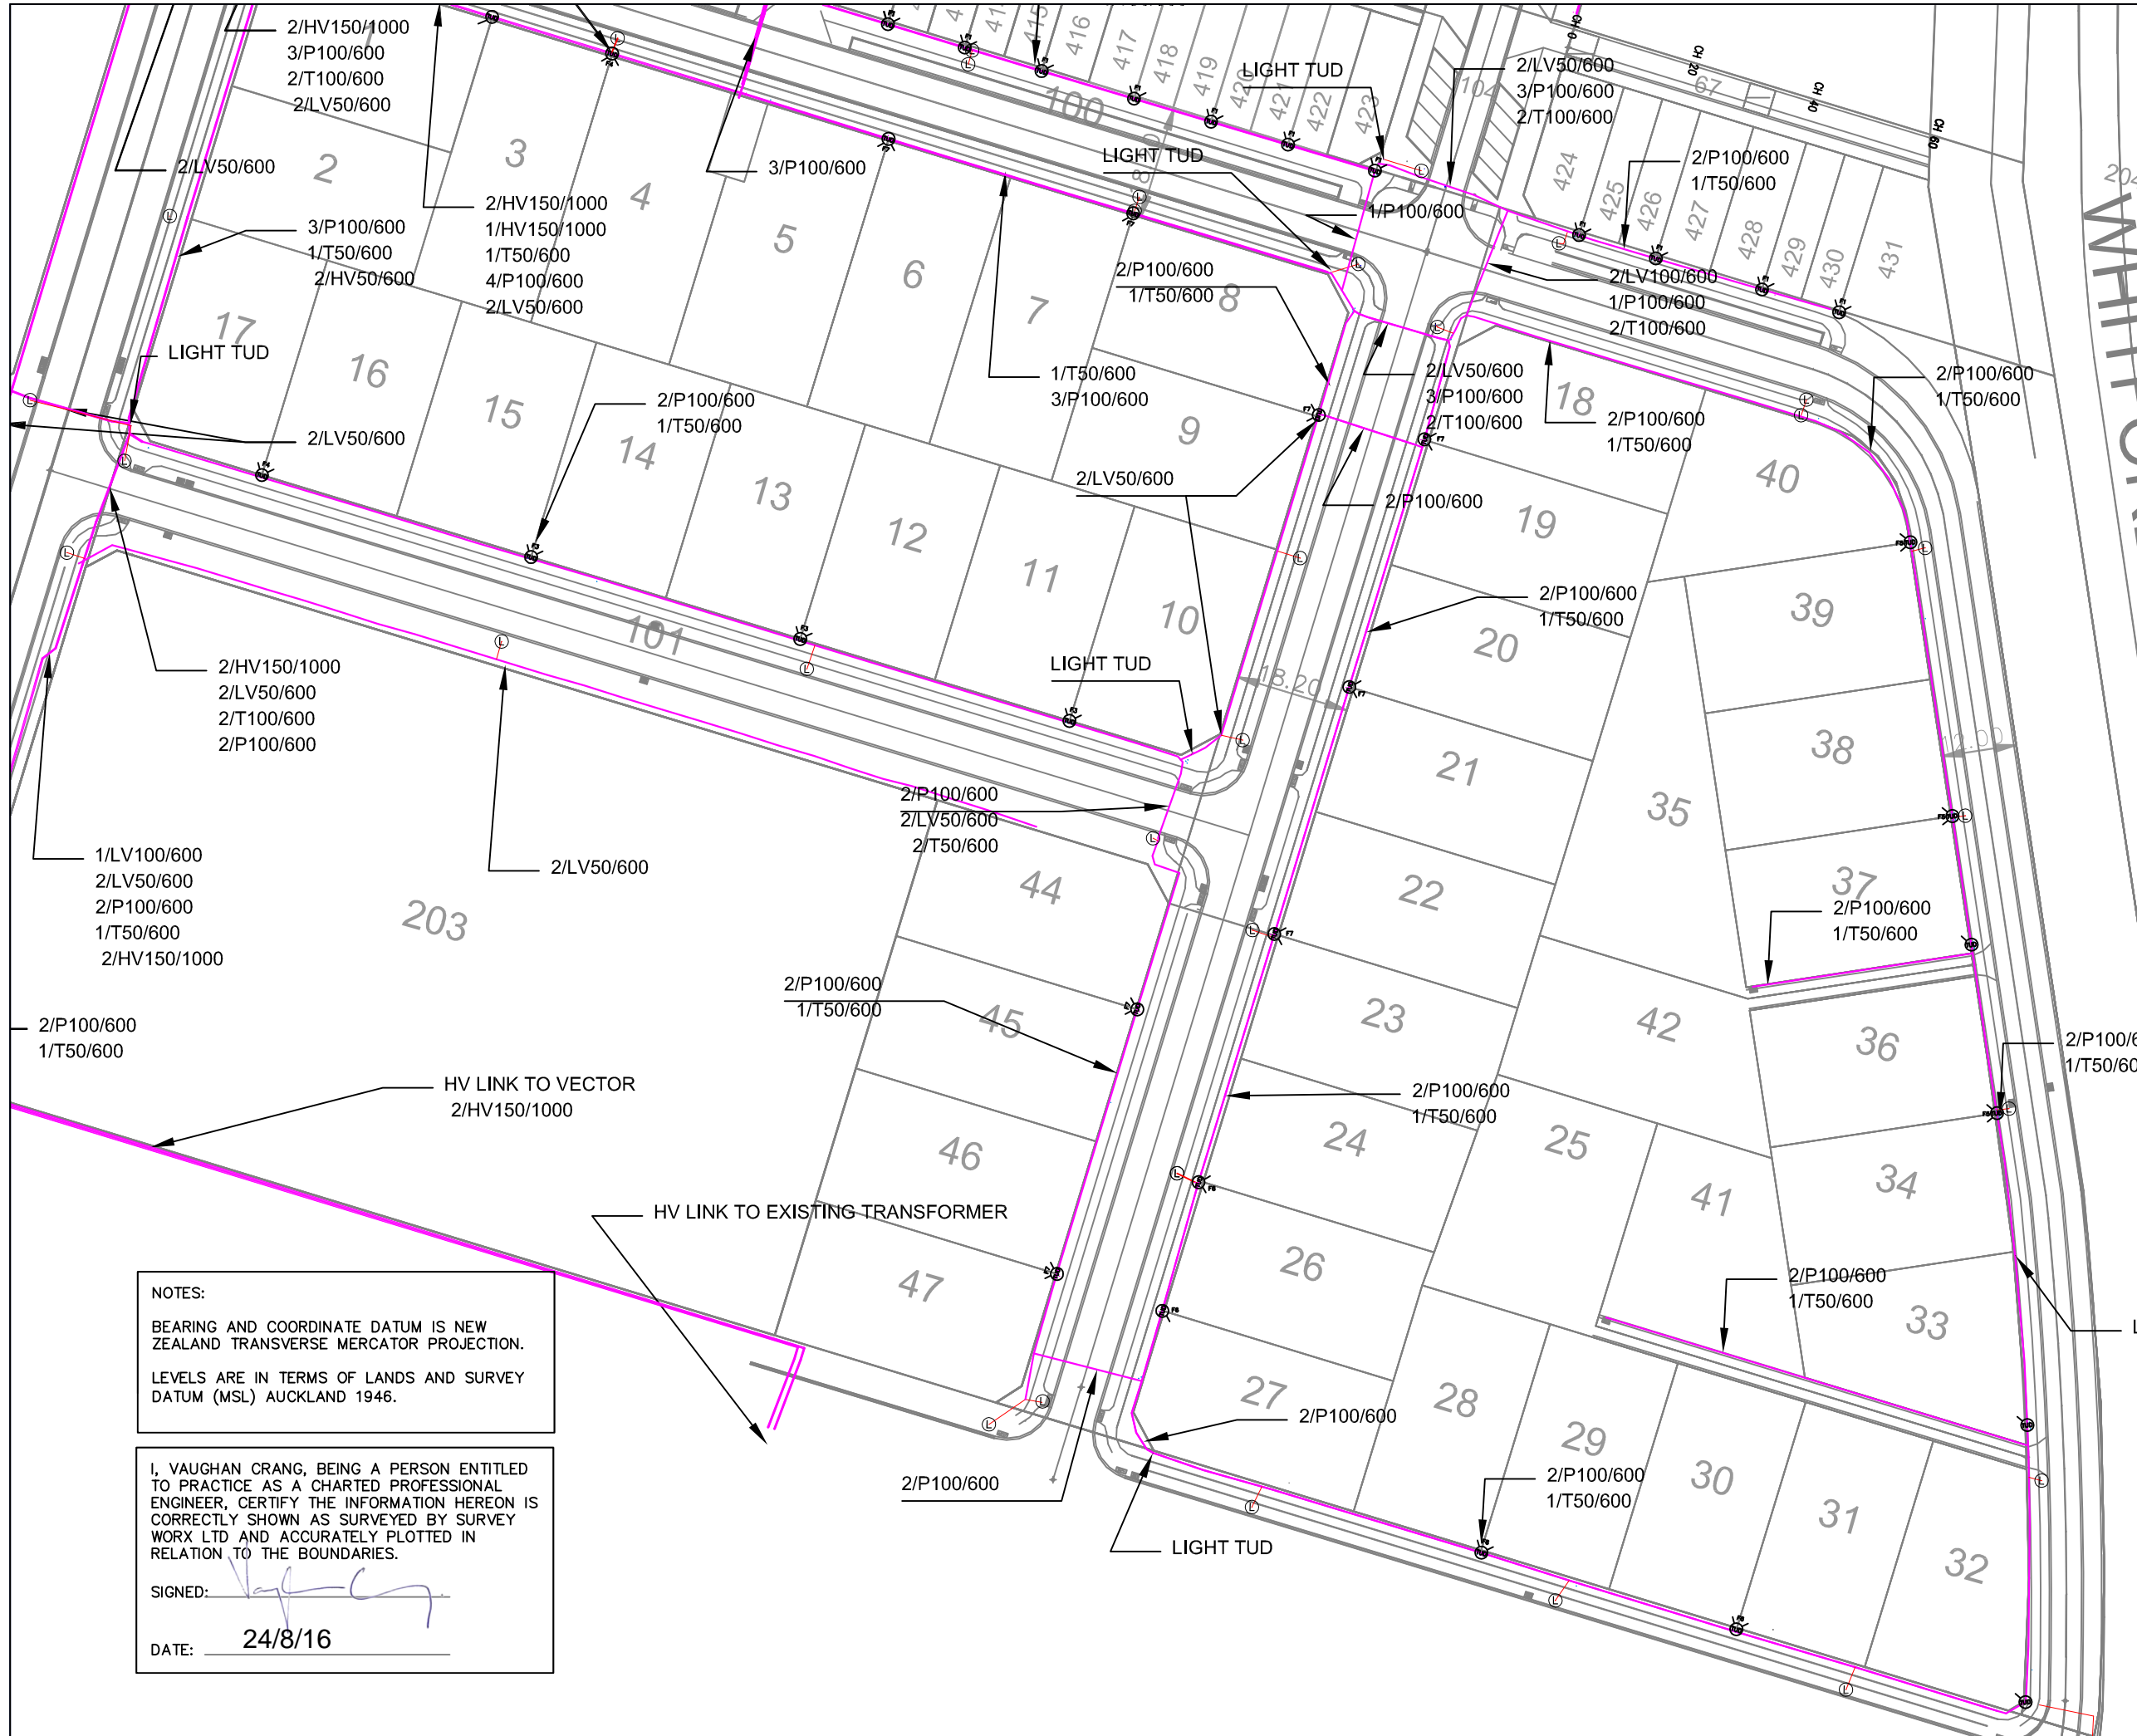

WHITFORD - MARRAET

NOTES:  
 BEARING AND COORDINATE DATUM IS NEW ZEALAND TRANSVERSE MERCATOR PROJECTION.  
 LEVELS ARE IN TERMS OF LANDS AND SURVEY DATUM (MSL) AUCKLAND 1946.

I, VAUGHAN CRANG, BEING A PERSON ENTITLED TO PRACTICE AS A CHARTED PROFESSIONAL ENGINEER, CERTIFY THE INFORMATION HEREON IS CORRECTLY SHOWN AS SURVEYED BY SURVEY WORX LTD AND ACCURATELY PLOTTED IN RELATION TO THE BOUNDARIES.  
 SIGNED:   
 DATE: 24/8/16

REVISION	CHANGES	CHECKED	DATE
A	UPDATED	TL	01/08/16
0	ORIGINAL ISSUE	TL	14/07/16

COPYRIGHT:  
 This document and the copyright in this document remain the property of Crang Consulting Ltd. The contents of this document may not be reproduced either in whole or in part by any means whatsoever without the prior written consent of Crang Consulting.


**CRANG CIVIL**  
 CONSULTING ENGINEERS  
 phone +64 09 281 4979  
 web www.crangcivil.co.nz  
 address Unit 4, 517 Mount Wellington High Way, Auckland  
 post PO Box 42-089, Orakei, Auckland 1745, NZ

CLIENT  
**GRAPHITE MANAGEMENT**

PROJECT  
**BEACHLANDS**

TITLE  
**POWER AS-BUILT SHEET 2**

DATE	SCALE
JUNE 2016	A1 1:500
DRAWN DW	A3 1:1000
DESIGNED	REVISION
DRAWING No. as-built power	SHEET 1 of 1

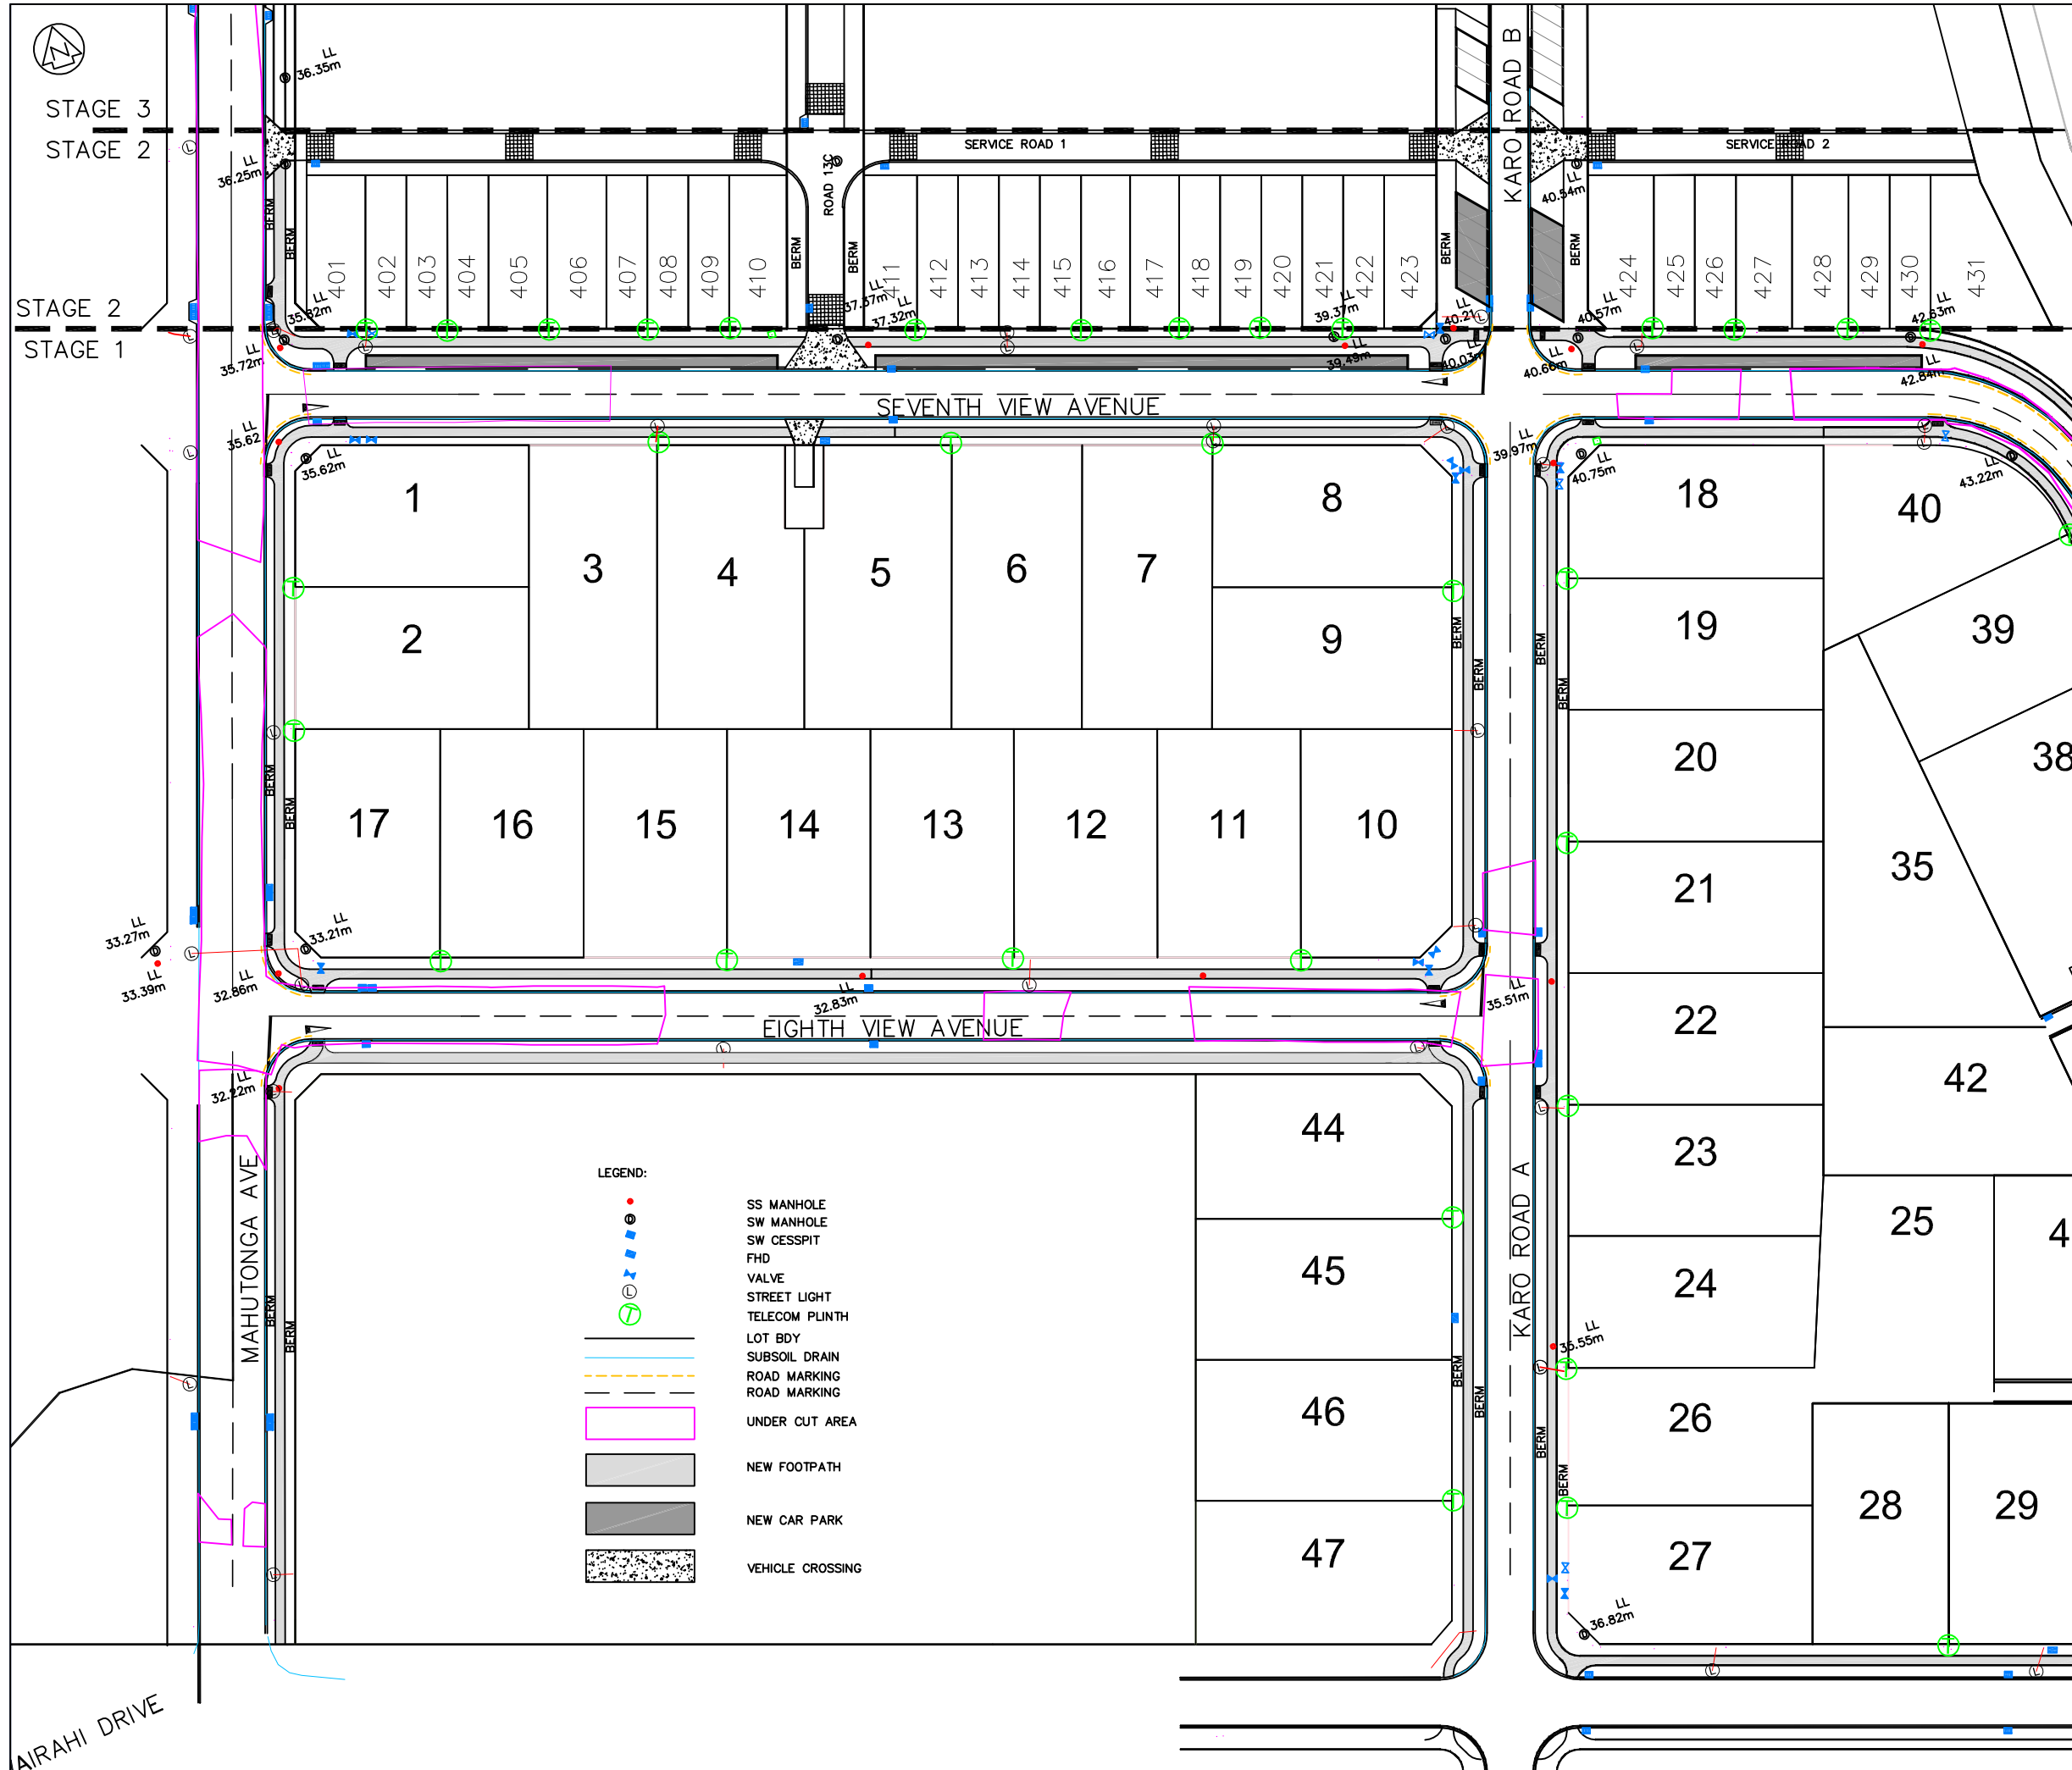

NOTES:  
 BEARING AND COORDINATE DATUM IS NEW ZEALAND TRANSVERSE MERCATOR PROJECTION.  
 LEVELS ARE IN TERMS OF LANDS AND SURVEY DATUM (MSL) AUCKLAND 1946.

I, VAUGHAN CRANG, BEING A PERSON ENTITLED TO PRACTICE AS A CHARTED PROFESSIONAL ENGINEER, CERTIFY THE INFORMATION HEREON IS CORRECTLY SHOWN AS SURVEYED BY DEMPSEY WOOD LTD AND ACCURATELY PLOTTED IN RELATION TO THE BOUNDARIES.

SIGNED: \_\_\_\_\_  
 DATE: 26/8/2016

- LEGEND:
- SS MANHOLE
  - SW MANHOLE
  - SW CESSPIT
  - FHD
  - VALVE
  - STREET LIGHT
  - TELECOM PLINTH
  - LOT BDY
  - SUBSOIL DRAIN
  - ROAD MARKING
  - ROAD MARKING
  - UNDER CUT AREA
  - NEW FOOTPATH
  - NEW CAR PARK
  - VEHICLE CROSSING

REVISION	CHANGES	CHECKED	DATE
A	UPDATED	TL	25/08/15
0	ORIGINAL ISSUE	TL	02/08/15

COPYRIGHT:  
 This document and the copyright in this document remain the property of Crang Consulting Ltd. The contents of this document may not be reproduced either in whole or in part by any means whatsoever without the prior written consent of Crang Consulting.

**CRANG CIVIL**  
 CONSULTING ENGINEERS

phone +64 09 281 4979  
 web www.crangcivil.co.nz  
 address 6 Aranui Road, Sylvia Park, Auckland, NZ  
 post PO Box 42-089, Orakei, Auckland 1745, NZ


CLIENT  
**GRAPHITE MANAGEMENT**

PROJECT  
**BEACHLANDS**

TITLE  
**STAGE 1 & 2 ROADING PLAN SHEET 1**

DATE	FEB 2015	SCALE	A1 1:500
DRAWN	DW	A3 1:1000	
DESIGNED		REVISION	
DRAWING No	as-built roading	SHEET	1 of 2

AIRAHU DRIVE

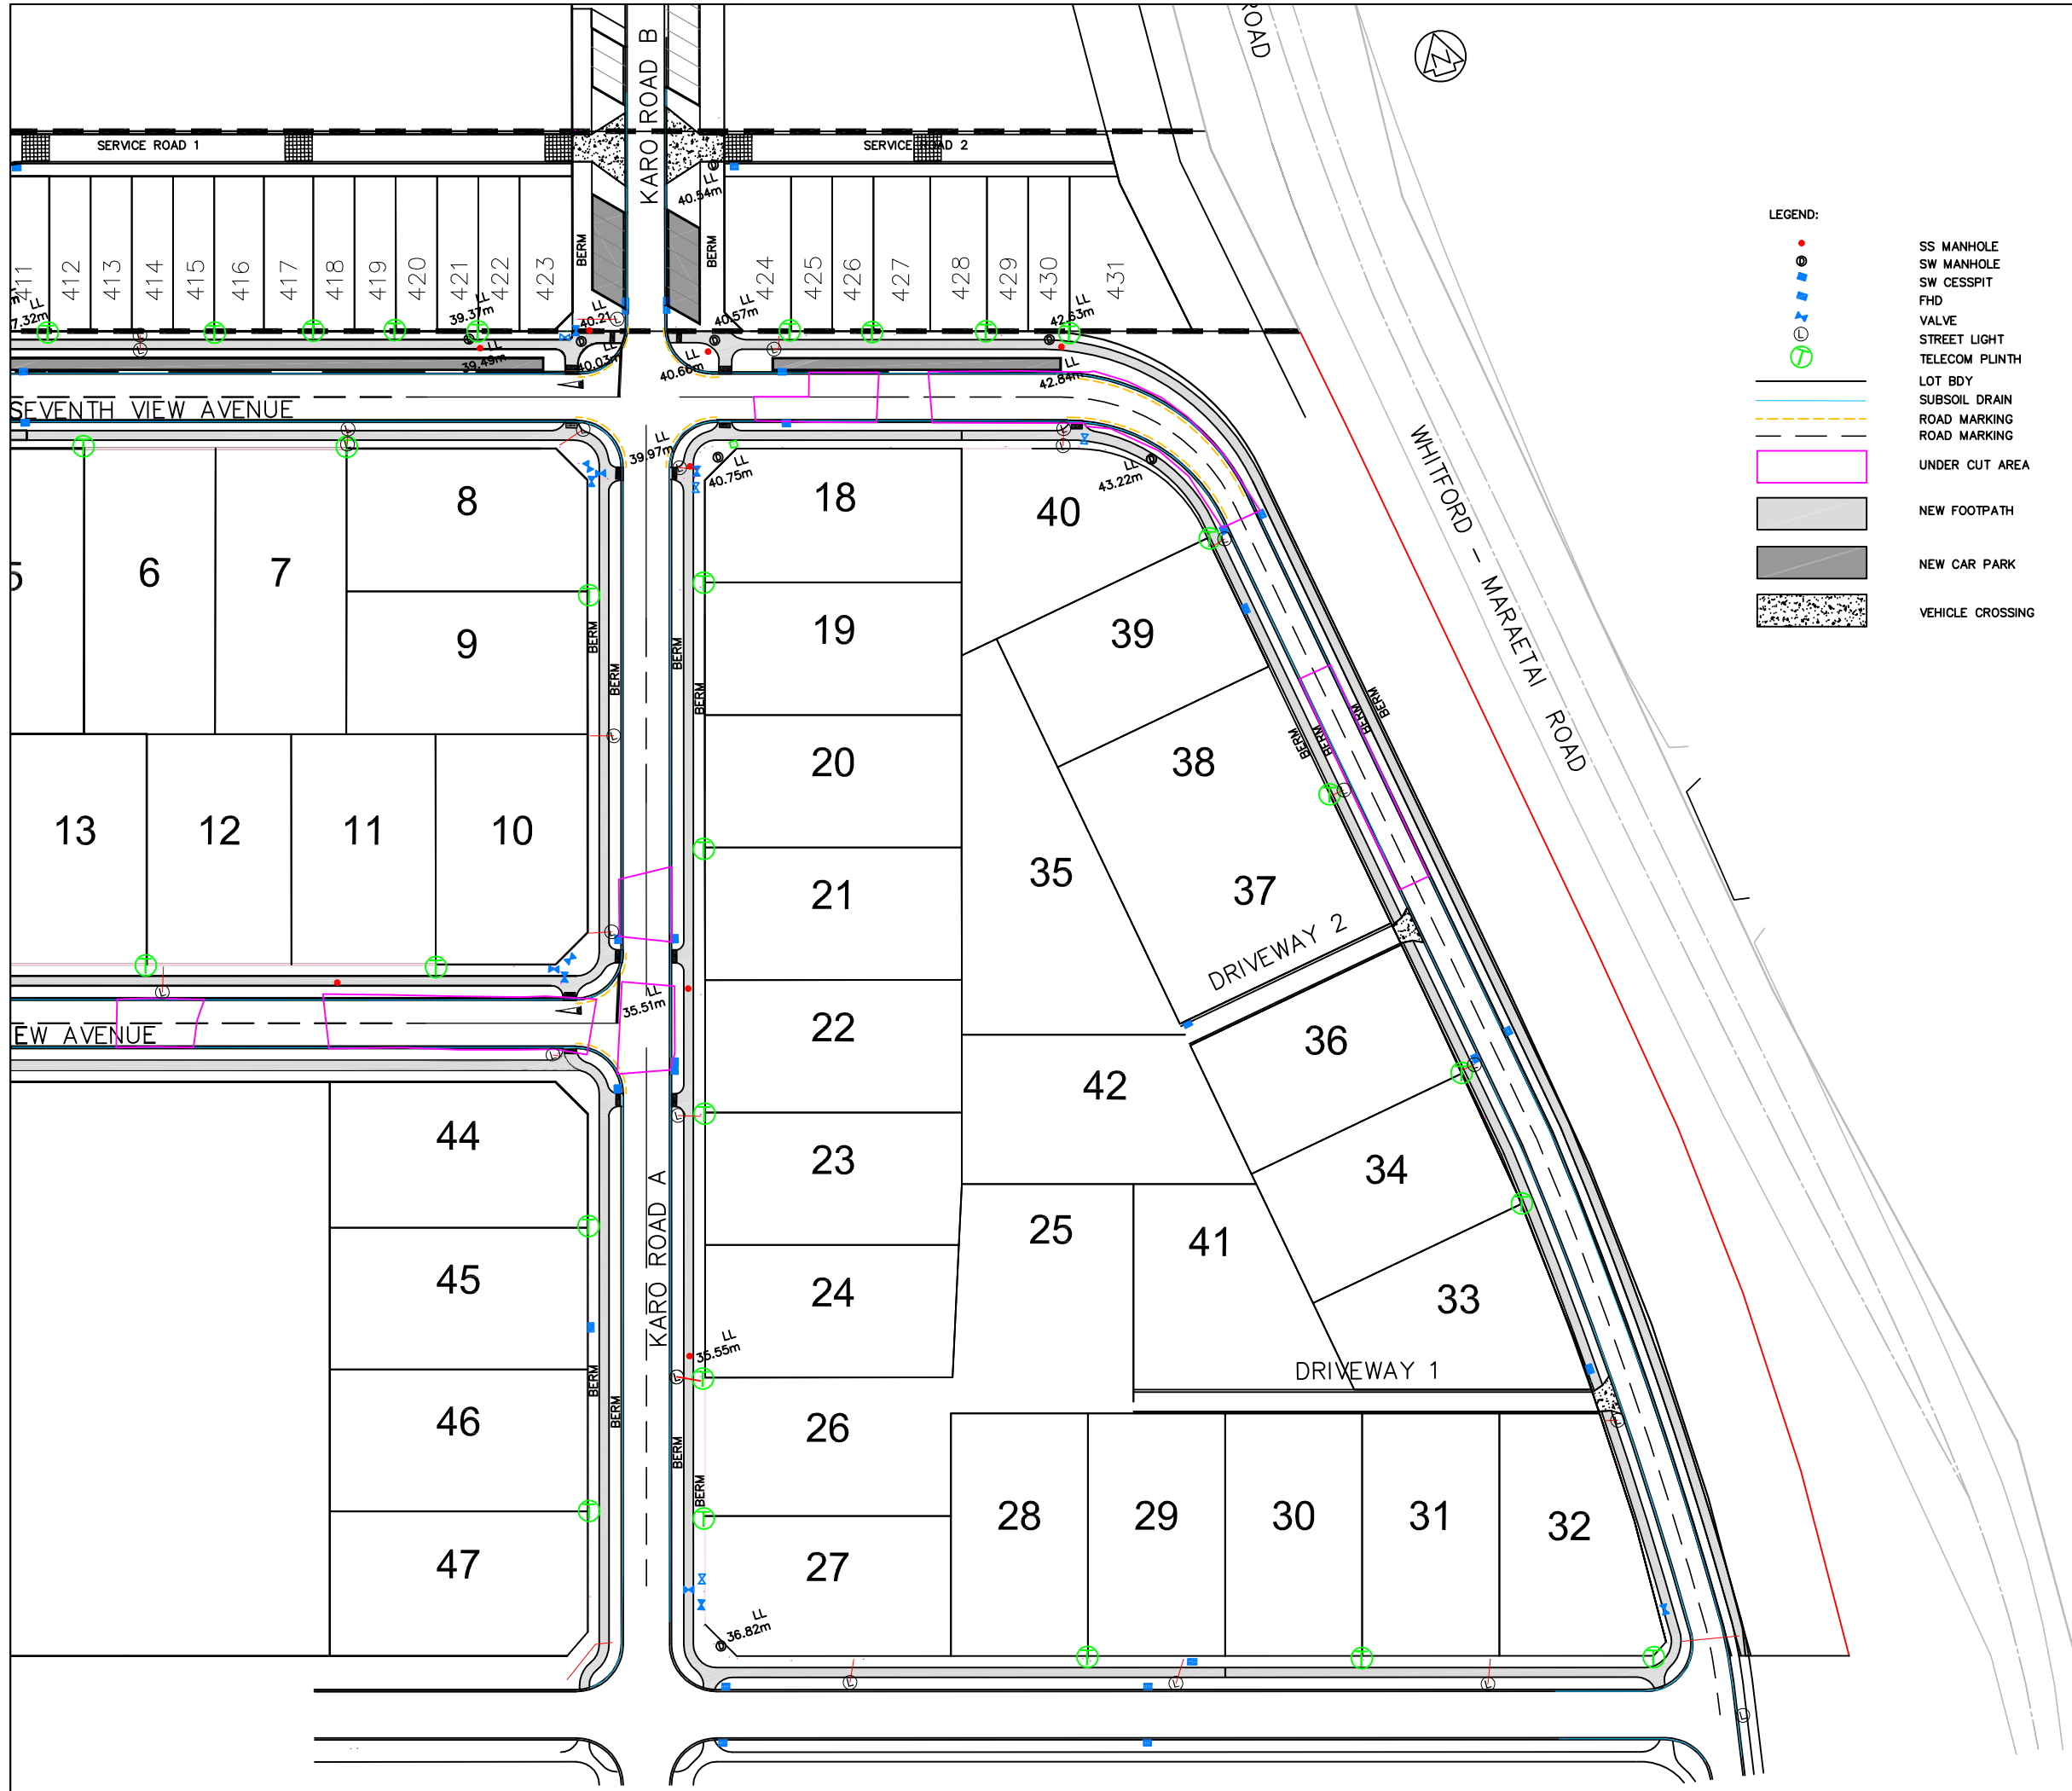

- LEGEND:**
- SS MANHOLE
  - SW MANHOLE
  - SW CESSPIT
  - FHD
  - VALVE
  - STREET LIGHT
  - TELECOM PLINTH
  - LOT BDY
  - SUBSOIL DRAIN
  - ROAD MARKING
  - ROAD MARKING
  - UNDER CUT AREA
  - NEW FOOTPATH
  - NEW CAR PARK
  - VEHICLE CROSSING

**NOTES:**  
 BEARING AND COORDINATE DATUM IS NEW ZEALAND TRANSVERSE MERCATOR PROJECTION.  
 LEVELS ARE IN TERMS OF LANDS AND SURVEY DATUM (MSL) AUCKLAND 1946.

I, VAUGHAN CRANG, BEING A PERSON ENTITLED TO PRACTICE AS A CHARTED PROFESSIONAL ENGINEER, CERTIFY THE INFORMATION HEREON IS CORRECTLY SHOWN AS SURVEYED BY DEMPSEY WOOD LTD AND ACCURATELY PLOTTED IN RELATION TO THE BOUNDARIES.

SIGNED: *V. Crang*  
 DATE: 26/8/2016

REVISION	CHANGES	CHECKED	DATE
A	UPDATED	TL	25/08/15
0	ORIGINAL ISSUE	TL	02/08/15

**COPYRIGHT:**  
 This document and the copyright in this document remain the property of Crang Consulting Ltd. The contents of this document may not be reproduced either in whole or in part by any means whatsoever without the prior written consent of Crang Consulting.

**CRANG CIVIL**  
 CONSULTING ENGINEERS

phone +64 09 281 4979  
 web www.crangcivil.co.nz  
 address 6 Aranui Road, Sylvia Park, Auckland, NZ  
 post PO Box 42-089, Orakei, Auckland 1745, NZ

CLIENT  
**GRAPHITE MANAGEMENT**

PROJECT  
**BEACHLANDS**

TITLE  
**STAGE 1 & 2 ROADING  
 PLAN SHEET 2**

DATE	FEB 2015	SCALE	A1 1:500
DRAWN	DW	A3 1:1000	
DESIGNED		REVISION	
DRAWING No	as-built roading	SHEET	2 of 2

NOTES:  
 BEARING AND COORDINATE DATUM IS NEW ZEALAND TRANSVERSE MERCATOR PROJECTION.  
 LEVELS ARE IN TERMS OF LANDS AND SURVEY DATUM (MSL) AUCKLAND 1946.

I, VAUGHAN CRANG, BEING A PERSON ENTITLED TO PRACTICE AS A CHARTED PROFESSIONAL ENGINEER, CERTIFY THE INFORMATION HEREON IS CORRECTLY SHOWN AS SURVEYED BY SURVEY WORX LTD AND ACCURATELY PLOTTED IN RELATION TO THE BOUNDARIES.

SIGNED: \_\_\_\_\_

DATE: \_\_\_\_\_



REVISION	CHANGES	CHECKED	DATE
0	ORIGINAL ISSUE	TL	14/07/16

COPYRIGHT:  
 This document and the copyright in this document remain the property of Crang Consulting Ltd. The contents of this document may not be reproduced either in whole or in part by any means whatsoever without the prior written consent of Crang Consulting.

**CRANG CIVIL**  
 CONSULTING ENGINEERS  
 phone +64 09 281 4979  
 web www.crangcivil.co.nz  
 address Unit 4, 517 Mount Wellington High Way, Auckland  
 post PO Box 42-089, Orakei, Auckland 1745, NZ

CLIENT  
**GRAPHITE MANAGEMENT**

PROJECT  
**BEACHLANDS**

TITLE  
**TELECOM AS-BUILT SHEET 1**


DATE	JUNE 2016	SCALE	A1 1:500
DRAWN	DW	A3	1:1000
DRAWING No	as-built telecom	SHEET	1 of 1
REVISION	0		


NOTES:  
 BEARING AND COORDINATE DATUM IS NEW ZEALAND TRANSVERSE MERCATOR PROJECTION.  
 LEVELS ARE IN TERMS OF LANDS AND SURVEY DATUM (MSL) AUCKLAND 1946.

I, VAUGHAN CRANG, BEING A PERSON ENTITLED TO PRACTICE AS A CHARTED PROFESSIONAL ENGINEER, CERTIFY THE INFORMATION HEREON IS CORRECTLY SHOWN AS SURVEYED BY SURVEY WORX LTD AND ACCURATELY PLOTTED IN RELATION TO THE BOUNDARIES.


SIGNED: 

DATE: 24/8/16

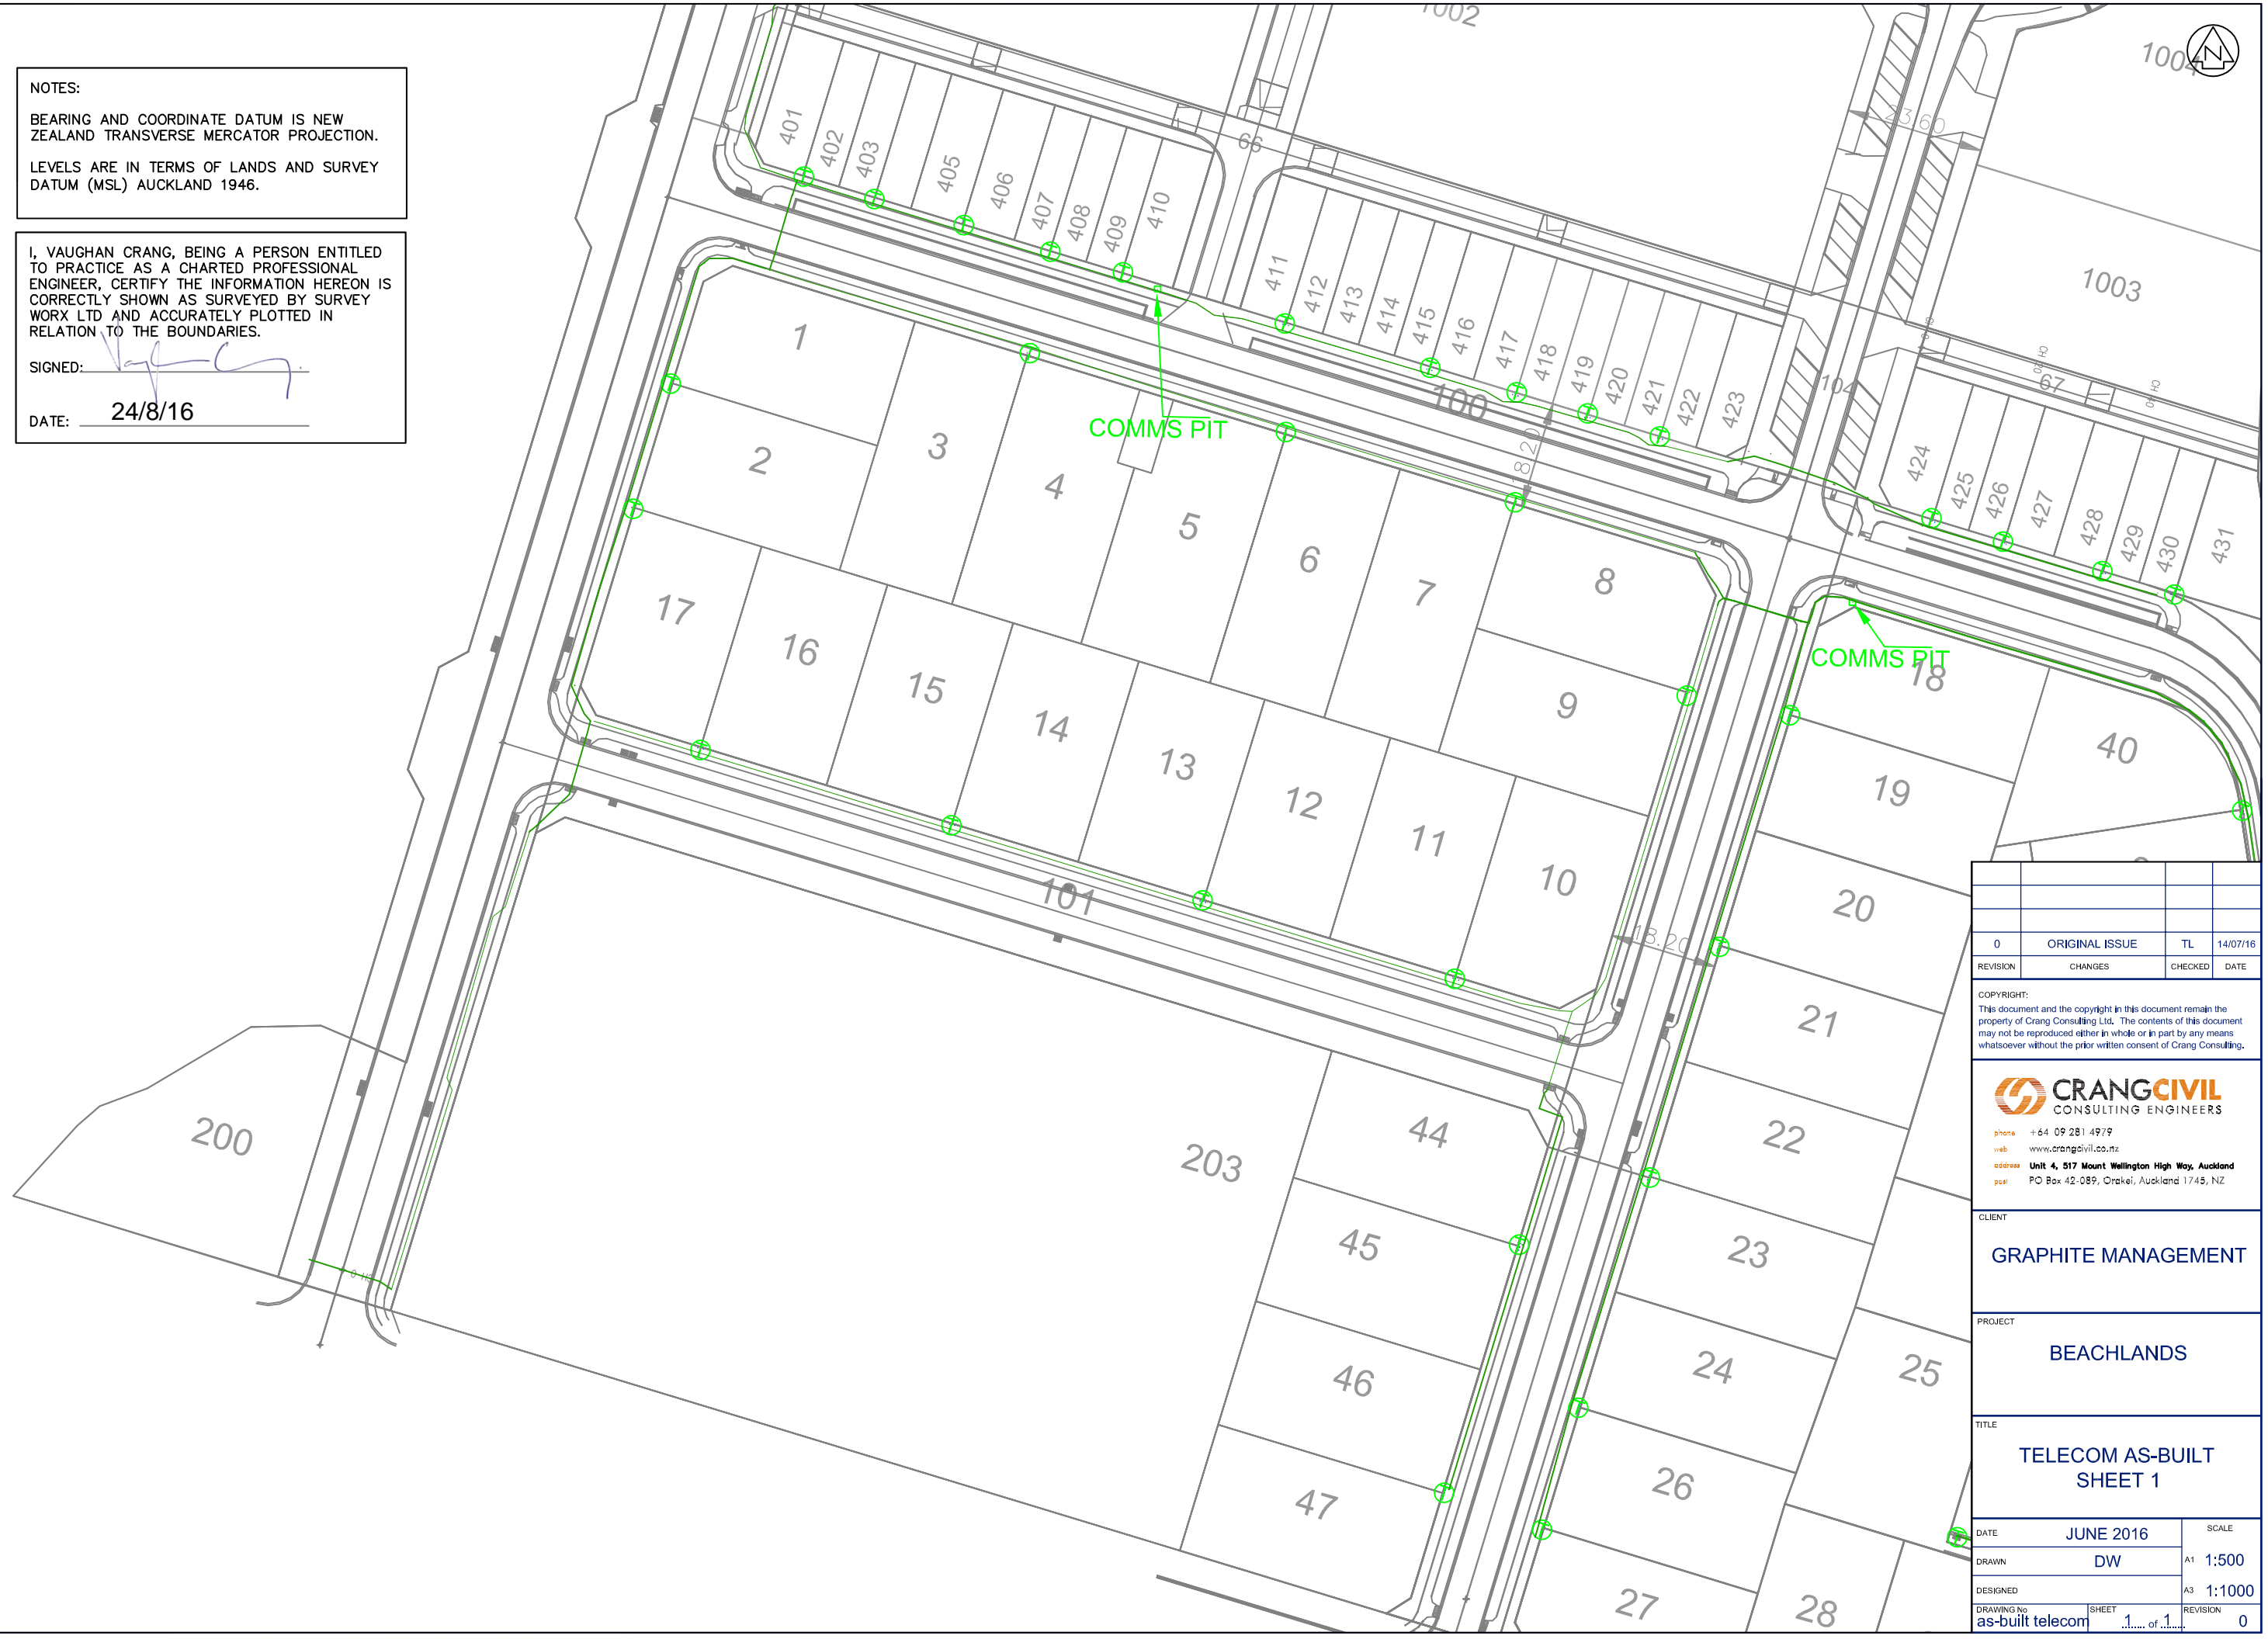

0	ORIGINAL ISSUE	TL	14/07/16
REVISION	CHANGES	CHECKED	DATE
COPYRIGHT: This document and the copyright in this document remain the property of Crang Consulting Ltd. The contents of this document may not be reproduced either in whole or in part by any means whatsoever without the prior written consent of Crang Consulting.			
 <b>CRANG CIVIL</b> CONSULTING ENGINEERS phone +64 09 281 4979 web www.crangcivil.co.nz address Unit 4, 517 Mount Wellington High Way, Auckland post PO Box 42-089, Orakei, Auckland 1745, NZ			
CLIENT <b>GRAPHITE MANAGEMENT</b>			
PROJECT <b>BEACHLANDS</b>			
TITLE <b>TELECOM AS-BUILT SHEET 1</b>			
DATE	JUNE 2016	SCALE	
DRAWN	DW	A1	1:500
DESIGNED		A3	1:1000
DRAWING No	as-built telecom	SHEET	1 of 1
		REVISION	0



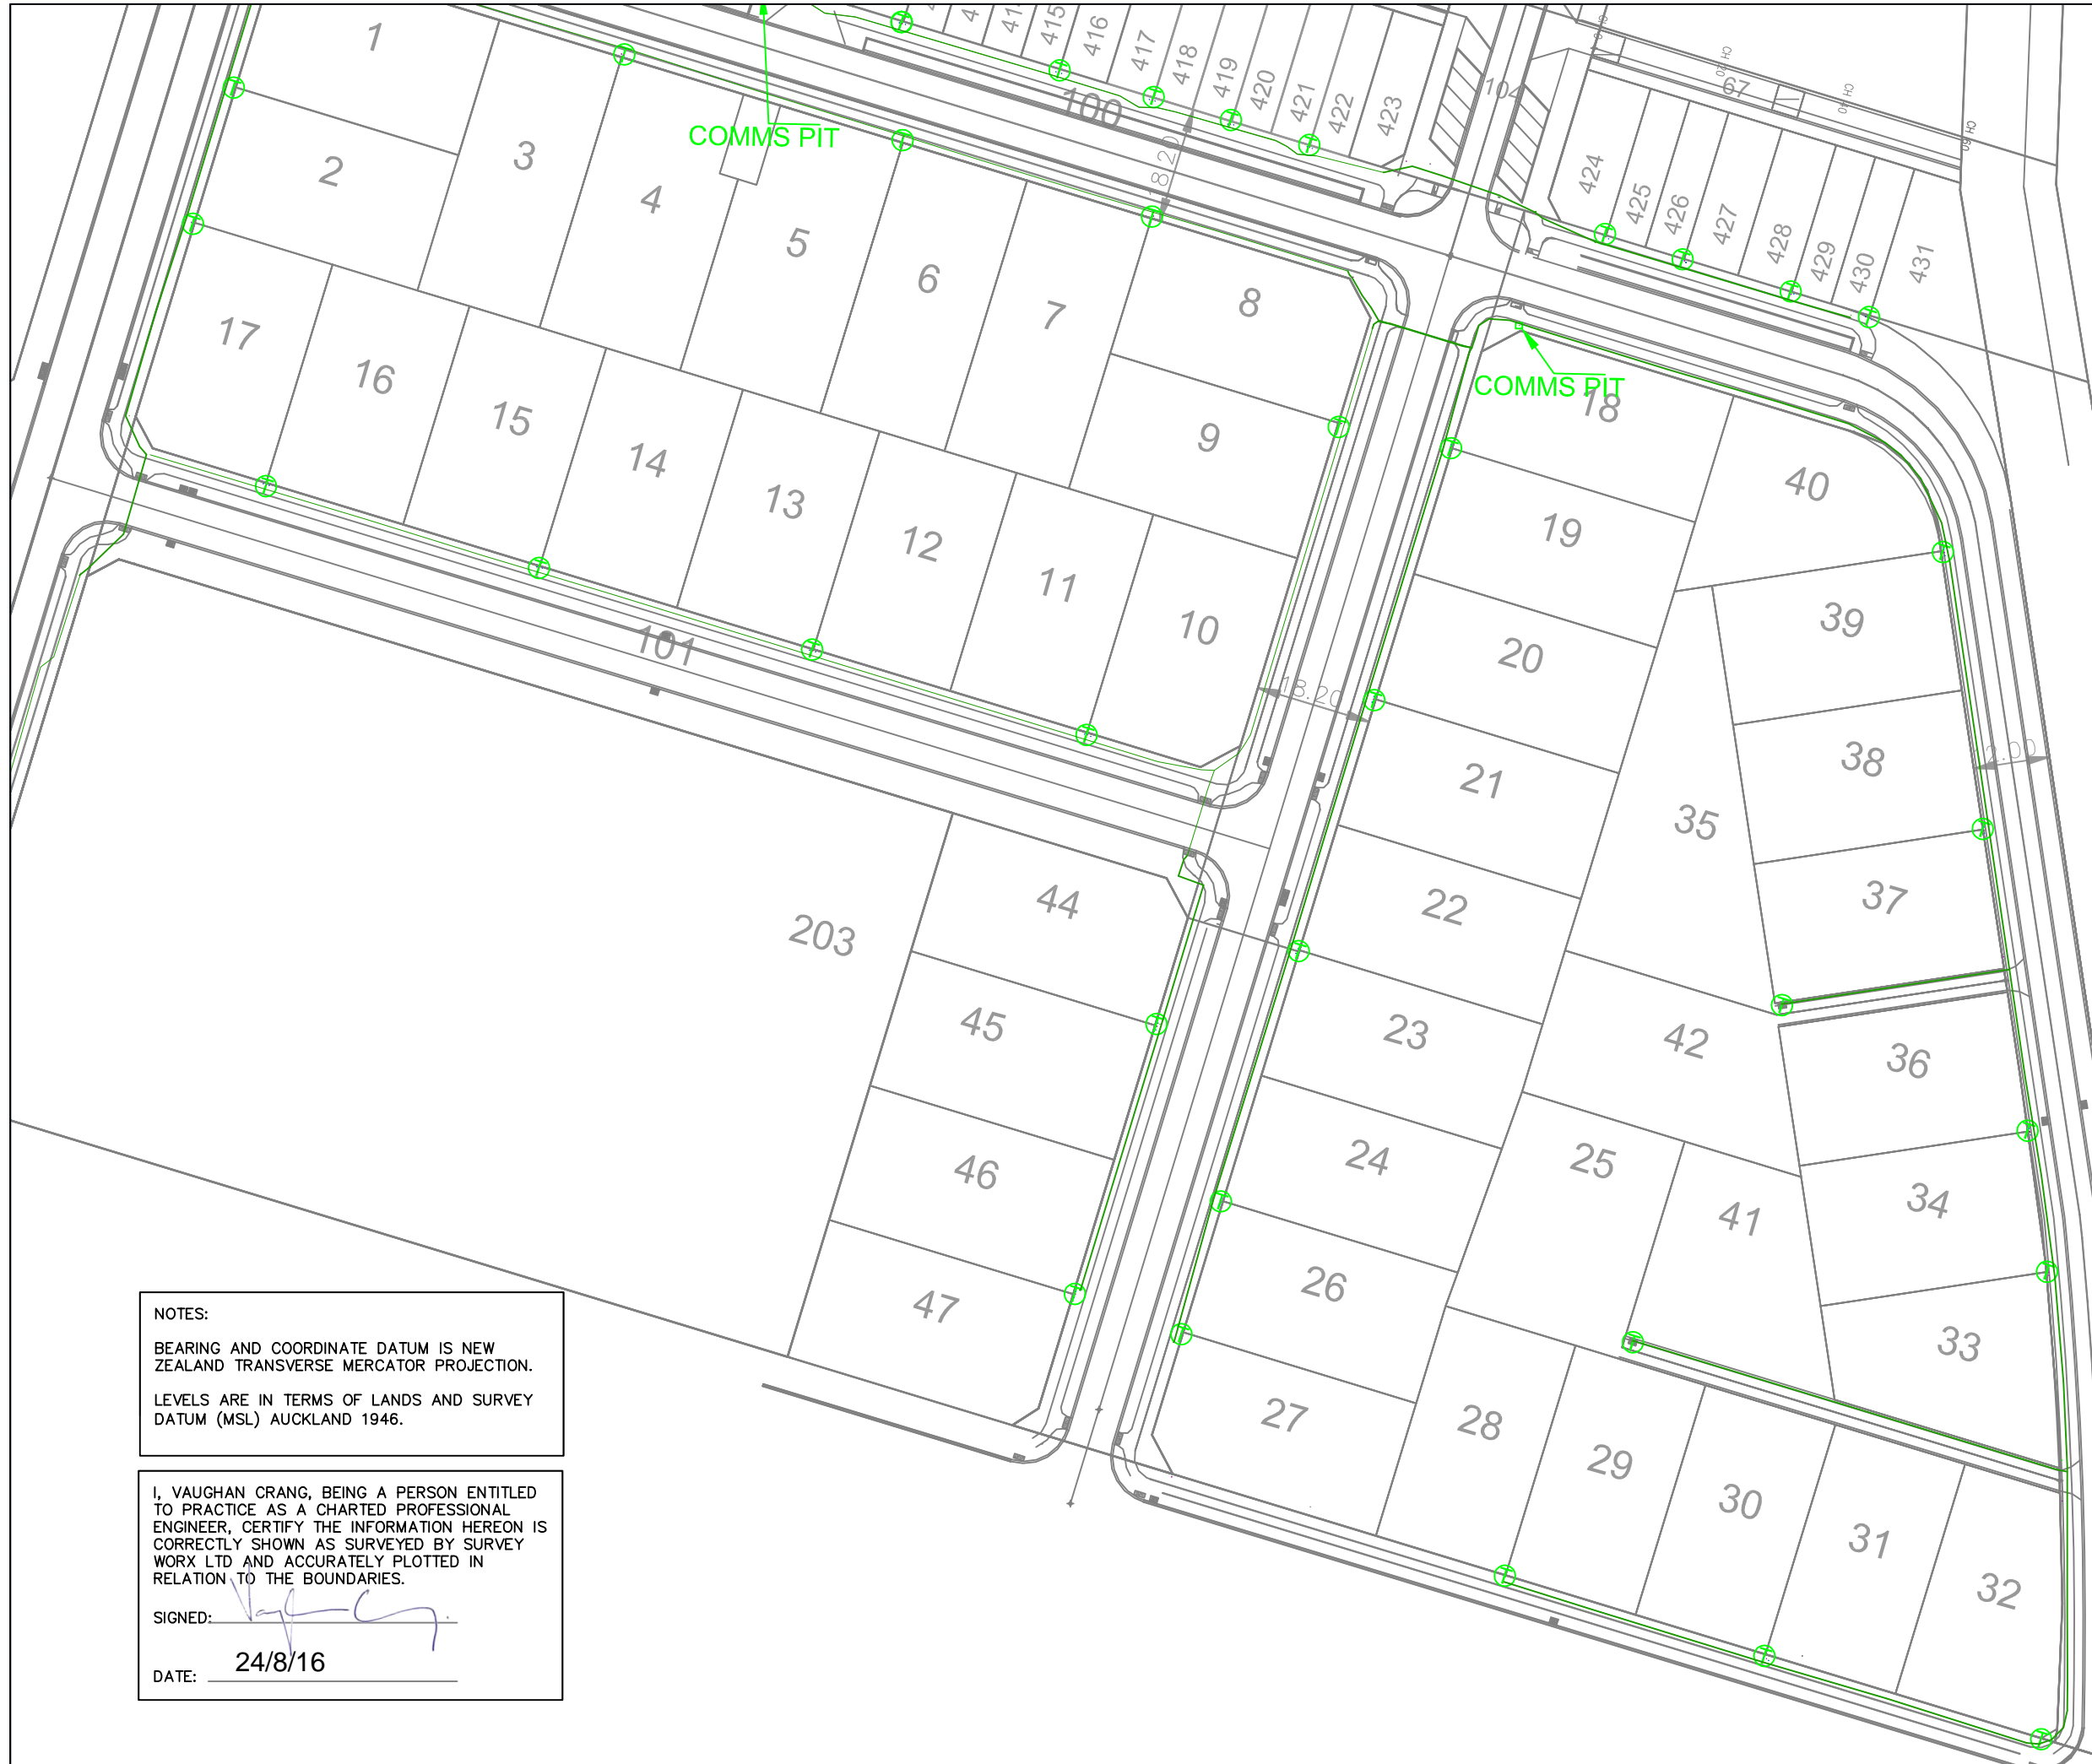

WHITFORD - MARAET

NOTES:  
 BEARING AND COORDINATE DATUM IS NEW ZEALAND TRANSVERSE MERCATOR PROJECTION.  
 LEVELS ARE IN TERMS OF LANDS AND SURVEY DATUM (MSL) AUCKLAND 1946.

I, VAUGHAN CRANG, BEING A PERSON ENTITLED TO PRACTICE AS A CHARTED PROFESSIONAL ENGINEER, CERTIFY THE INFORMATION HEREON IS CORRECTLY SHOWN AS SURVEYED BY SURVEY WORK LTD AND ACCURATELY PLOTTED IN RELATION TO THE BOUNDARIES.  
 SIGNED:   
 DATE: 24/8/16

REVISION	CHANGES	CHECKED	DATE
0	ORIGINAL ISSUE	TL	14/07/16

COPYRIGHT:  
 This document and the copyright in this document remain the property of Crang Consulting Ltd. The contents of this document may not be reproduced either in whole or in part by any means whatsoever without the prior written consent of Crang Consulting.

**CRANG CIVIL**  
 CONSULTING ENGINEERS  
 phone +64 09 281 4979  
 web www.crangcivil.co.nz  
 address Unit 4, 517 Mount Wellington High Way, Auckland  
 post PO Box 42-089, Orakei, Auckland 1745, NZ

CLIENT  
**GRAPHITE MANAGEMENT**


PROJECT  
**BEACHLANDS**


TITLE  
**TELECOM AS-BUILT SHEET 2**

DATE	JUNE 2016	SCALE	A1 1:500
DRAWN	DW	A3	1:1000
DESIGNED		SHEET	1 of 1
DRAWING No	as-built telecom	REVISION	0

NOTES:  
 BEARING AND COORDINATE DATUM IS NEW ZEALAND TRANSVERSE MERCATOR PROJECTION.  
 LEVELS ARE IN TERMS OF LANDS AND SURVEY DATUM (MSL) AUCKLAND 1946.

I, VAUGHAN CRANG, BEING A PERSON ENTITLED TO PRACTICE AS A CHARTED PROFESSIONAL ENGINEER, CERTIFY THE INFORMATION HEREON IS CORRECTLY SHOWN AS SURVEYED BY SURVEY WORX LTD AND ACCURATELY PLOTTED IN RELATION TO THE BOUNDARIES.

SIGNED:   
 DATE: 24/8/16

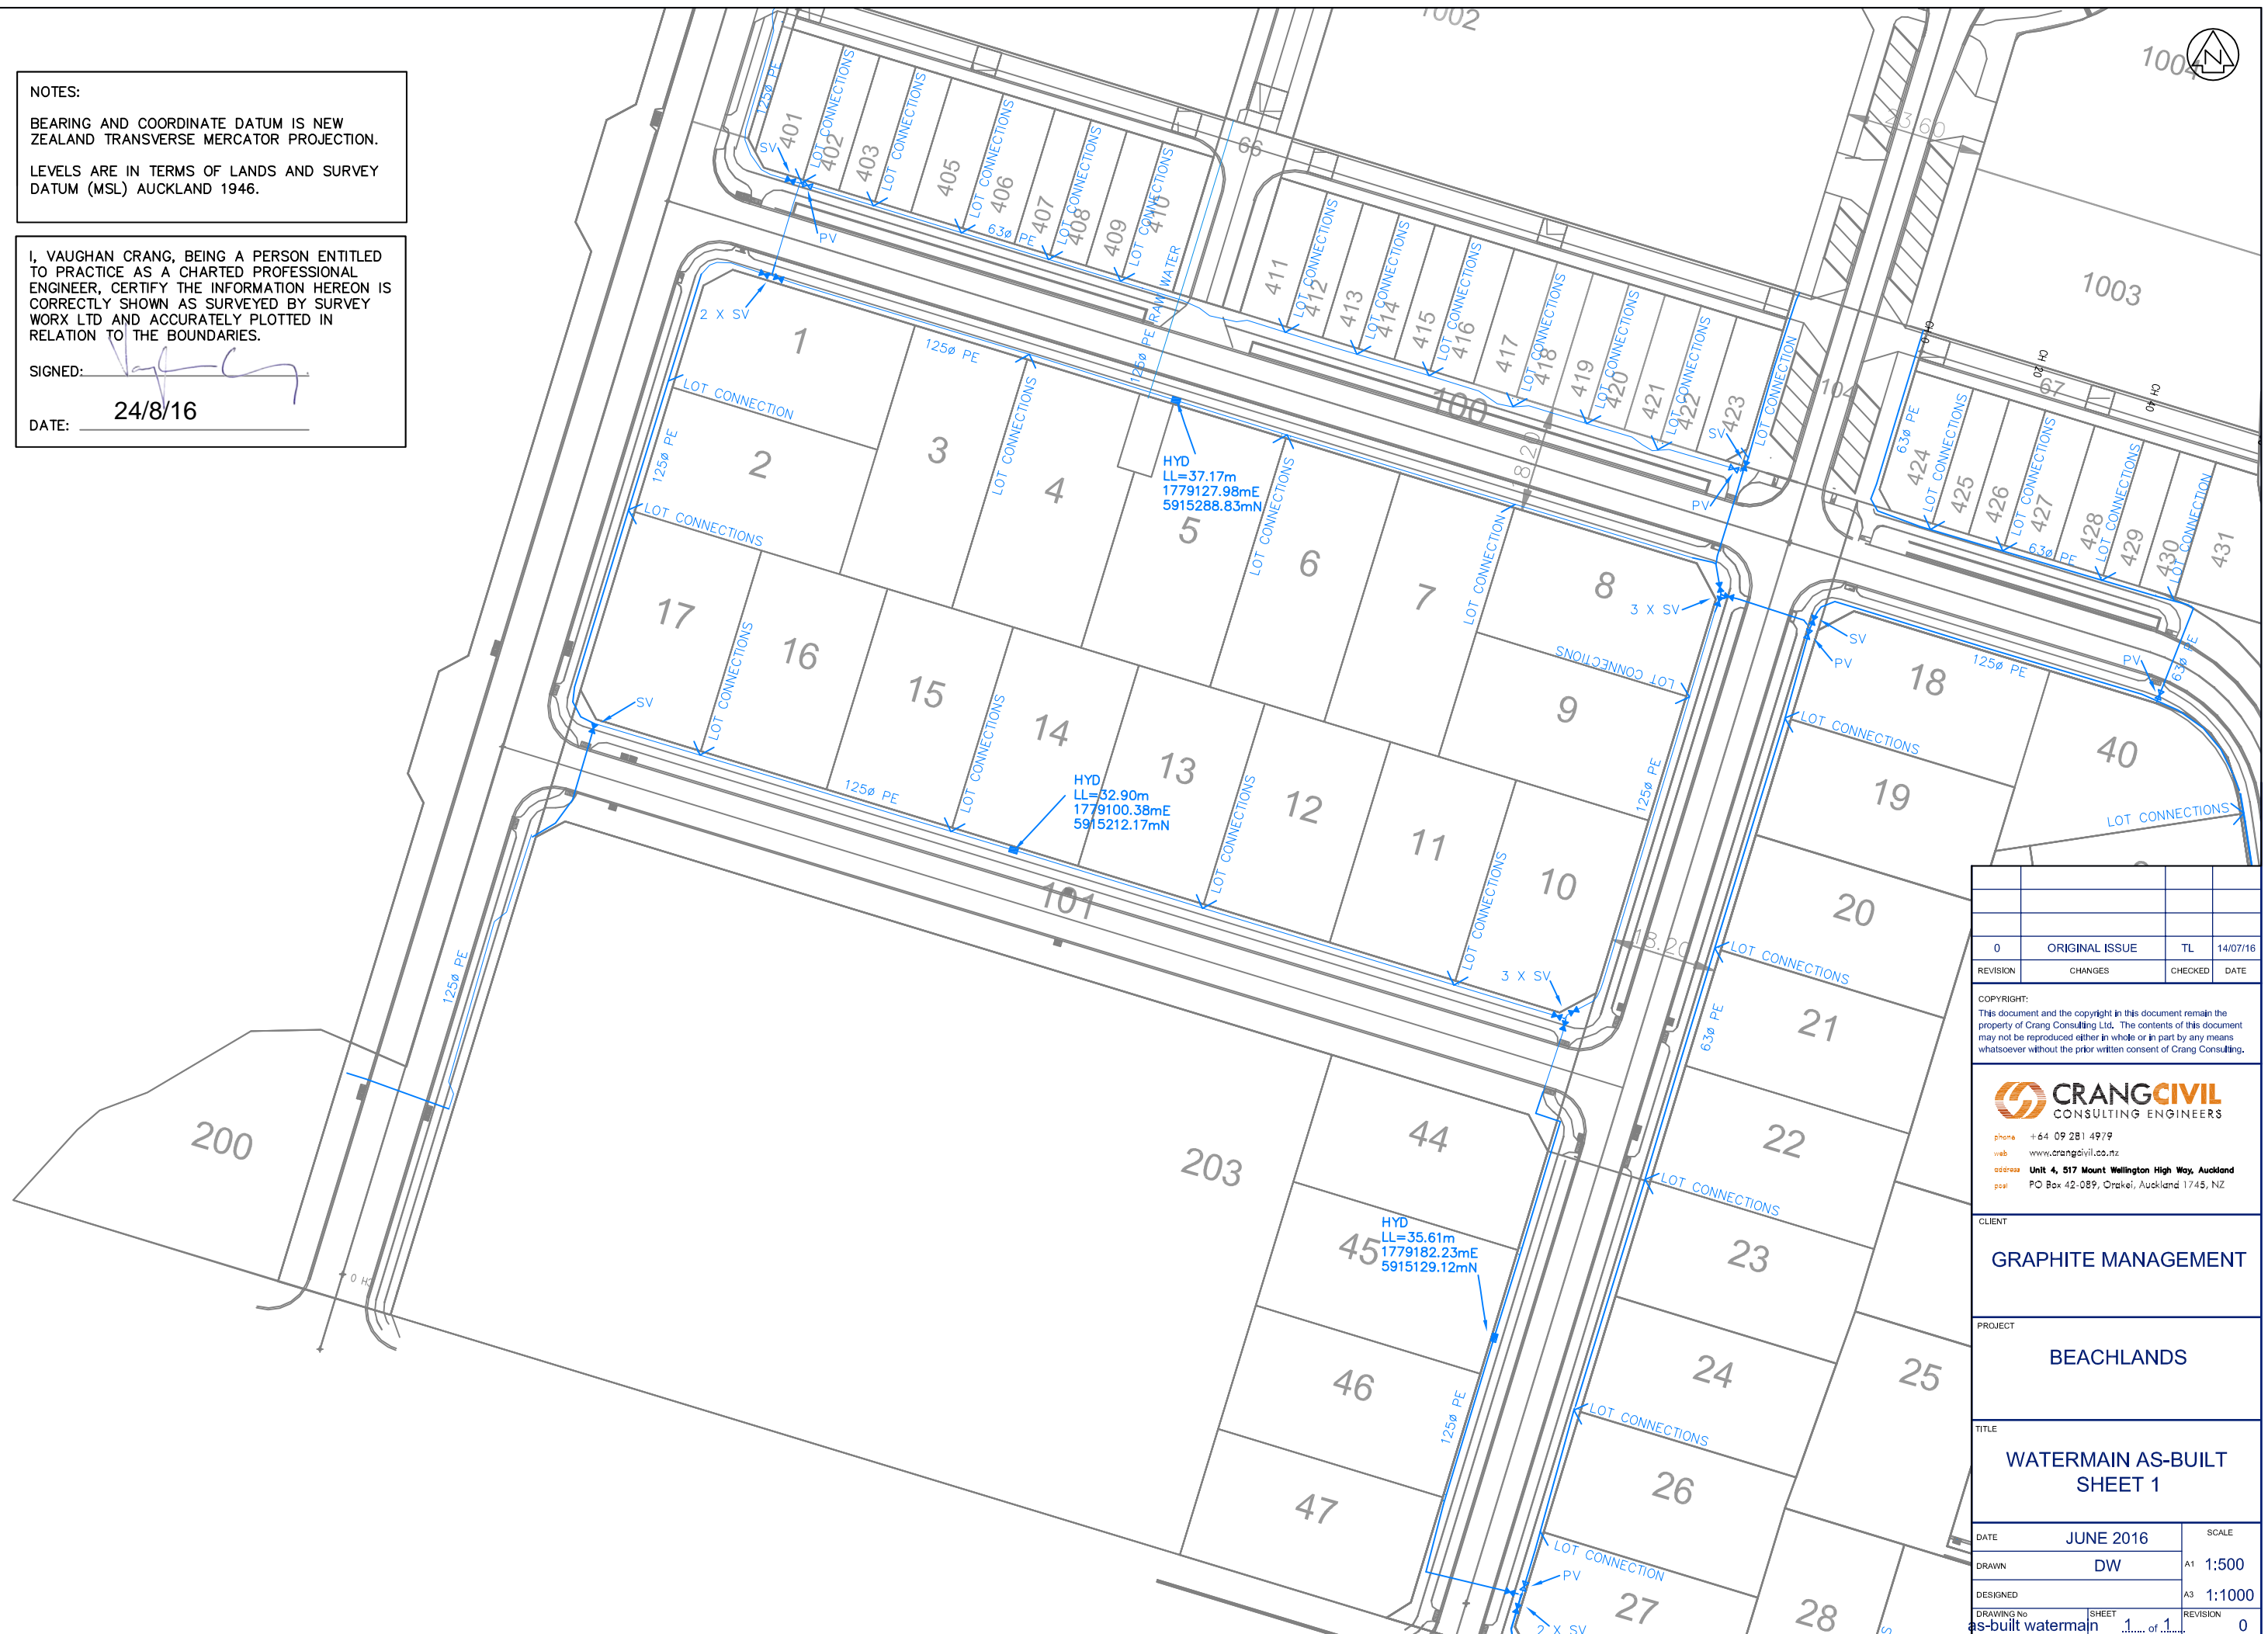

REVISION	CHANGES	CHECKED	DATE
0	ORIGINAL ISSUE	TL	14/07/16

COPYRIGHT:  
 This document and the copyright in this document remain the property of Crang Consulting Ltd. The contents of this document may not be reproduced either in whole or in part by any means whatsoever without the prior written consent of Crang Consulting.


**CRANGCIVIL**  
 CONSULTING ENGINEERS  
 phone +64 09 281 4979  
 web www.crangcivil.co.nz  
 address Unit 4, 517 Mount Wellington High Way, Auckland  
 post PO Box 42-089, Orakei, Auckland 1745, NZ

CLIENT  
**GRAPHITE MANAGEMENT**

PROJECT  
**BEACHLANDS**

TITLE  
**WATERMAIN AS-BUILT SHEET 1**

DATE	JUNE 2016	SCALE
DRAWN	DW	A1 1:500
DESIGNED		A3 1:1000
DRAWING No	as-built watermain	SHEET 1 of 1 REVISION 0

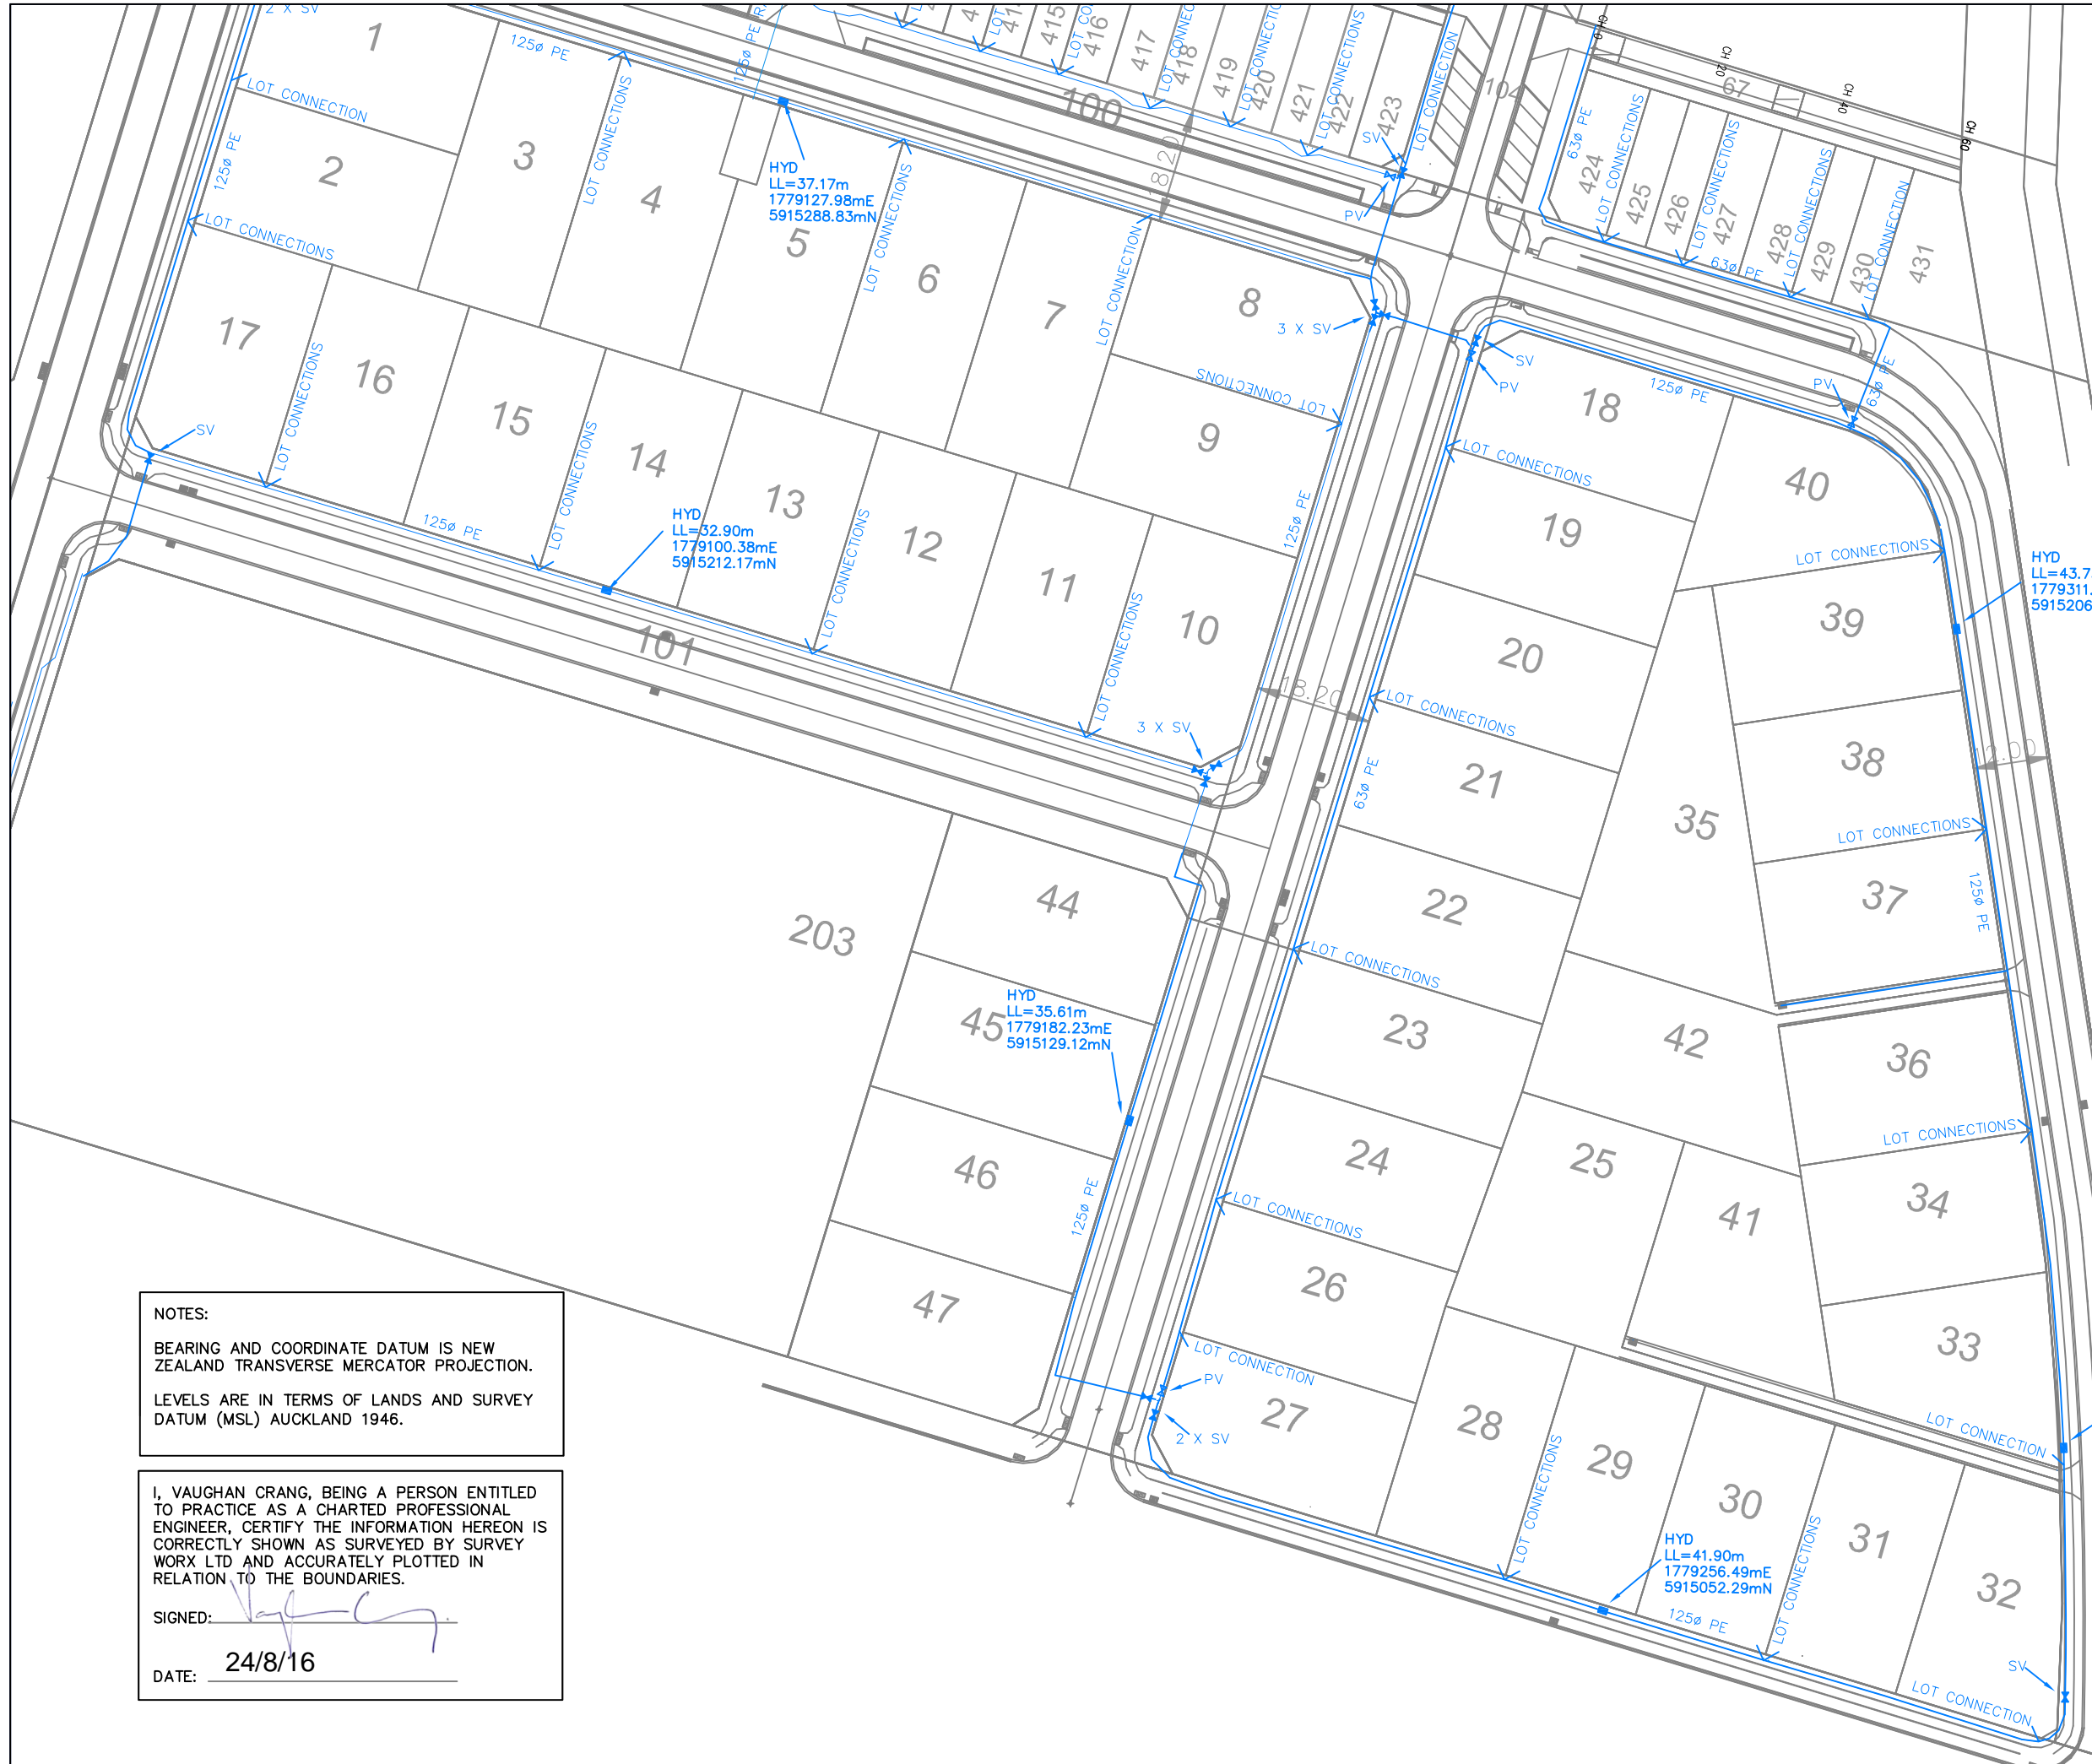

WHITFORD - MARAET

NOTES:  
 BEARING AND COORDINATE DATUM IS NEW ZEALAND TRANSVERSE MERCATOR PROJECTION.  
 LEVELS ARE IN TERMS OF LANDS AND SURVEY DATUM (MSL) AUCKLAND 1946.

I, VAUGHAN CRANG, BEING A PERSON ENTITLED TO PRACTICE AS A CHARTED PROFESSIONAL ENGINEER, CERTIFY THE INFORMATION HEREON IS CORRECTLY SHOWN AS SURVEYED BY SURVEY WORX LTD AND ACCURATELY PLOTTED IN RELATION TO THE BOUNDARIES.  
 SIGNED:   
 DATE: 24/8/16

REVISION	CHANGES	CHECKED	DATE
0	ORIGINAL ISSUE	TL	14/07/16

COPYRIGHT:  
 This document and the copyright in this document remain the property of Crang Consulting Ltd. The contents of this document may not be reproduced either in whole or in part by any means whatsoever without the prior written consent of Crang Consulting.

**CRANG CIVIL**  
 CONSULTING ENGINEERS  
 phone +64 09 281 4979  
 web www.crangcivil.co.nz  
 address Unit 4, 517 Mount Wellington High Way, Auckland  
 post PO Box 42-089, Orakei, Auckland 1745, NZ

CLIENT  
**GRAPHITE MANAGEMENT**

PROJECT  
**BEACHLANDS**

TITLE  
**WATERMAIN AS-BUILT SHEET 2**

DATE	JUNE 2016	SCALE
DRAWN	DW	A1 1:500
DESIGNED		A3 1:1000
DRAWING No	SHEET	REVISION
as-built watermain	1 of 1	0

HYD  
 LL=44.5  
 1779328  
 5915077